

JACKSON COUNTY
APPROVED LAND CORNER
P.A. 345 of 1990
 Acting Chairman *David Erickson*
 Date *6-11-97*

SOUTHWEST CORNER, SECTION 32
 HANOVER TOWNSHIP

LAND CORNER RECORDATION CERTIFICATE
 Filing Requirement of Act 74, Mich. P.A. 1970

#2037801
 Liber 1544 Page 370
 Page 1 of 2
 Jackson Co., MI
 Recorded
 05/11/97 11:30A
 Mindy Reilly
 Register of Deeds

For corners in
JACKSON
 (County)

Located In:	Corner Code #
T 4 S R 2 W	C-13
T R	
T R	
T R	
S T R	
S T R	
S T R	
S T R	

SURVEY & REMONUMENTATION

APR 07 1998


SECTION

Register of Deeds Stamp & File Number

- Public Land Survey
- Property Controlling in Section
- Miscellaneous Property in Sec.

- Lot No. _____, Recorded Plat _____
- Private Claims _____

I, DEAN R. GUTEKUNST, in a field survey on May 7, 1997 & May 28, 1997 do hereby certify that under requirements of P.A. 74, Michigan P.A. of 1970, the corner points mentioned in lines 1 and 2 above were in conformance with regulations and rules therefore as required in the current manual of survey instructions of the United States Department of the Interior, Bureau of Land Management or by a decree of a Court of Law and/or that the corner points mentioned in lines 3, 4 and 5 above were in conformance with the rules of the Michigan Board of Land Surveyors or by a Decree of a Court of Law: established, re-established, monumented, re-monumented, recovered, found as expressed below:

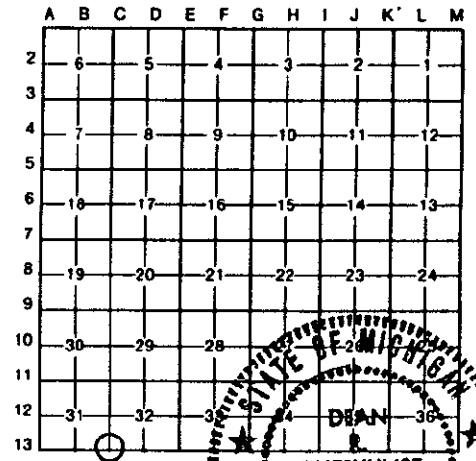

NOTE: Not more than 4 corners, all in the same town and range, may be recorded on this certificate.

A. Description of original monument and accessories and/or subsequent restoration:

- Original Government Post set by Joseph Wampler, Deputy Surveyor, 1823.
- B. Oak 16" N 84 E 34 links (22.44')
- B. Oak 14" N 48 W 13 links (8.58')
- Perpetuation by H. F. Bean, July 1886.
- Y. Oak 8" S 57 E 88½ links (58.41')
- Maple 6" N 24 W 56 links (36.96')

Post out, set post 146 links West of Corner Stone for 5 & 6 and set Stone 1 rod South of corner.

Continued on back,

B. Description of corner evidence found and/or method applied in restoring or reestablishing corner:

Found FIRECLAY with iron alongside. Fireclay broken into 3 pieces.
 Corner is 5'± South of center line of Weir Road (gravel) East & West and 9'± West of center line of Strait Road (gravel) running North.
 Accepted FIRECLAY as a careful and faithful perpetuation of the position of the original corner as remonumented by H. F. Bean in 1886.
 Set a Standard Jackson County Monument to replace the Fireclay and reset the bottom 13" of Fireclay, 4' below surface and below the monument. Set 2 broken pieces of fireclay on West and South side. Set stone around bottom of fireclay and left old iron buried beside monument.

C. Description of monument for corner and accessories established to perpetuate locating the position of the corner:

- C-13 T4S, R2W Corner is a 4" diameter X 30" Cast Iron Harrison monument with a brass cap stamped 18658, which is the standard monument for Jackson County.
- * S 65° E 33" Maple 49.04' Pole barn spike and washer on North side.
- ** N 37° W 28" Maple 32.02' Pole barn spike and washer on Northeast side.
- *** S 78° W 25" Maple (double 5' above ground) 40.00' Pole barn spike on North side.
- **** S 28° E 32" Maple 18.88' Pole barn spike and washer on West side.
- N 70° W 32" Maple 58.68' Pole barn spike and washer on Southwest side.
- N 17° E 27" Maple 120.60' Pole barn spike and washer on West side.
- South Steel post and survey marker sign attached 15.0'

signed by Dean R. Gutekunst Date June 1, 1997
 Surveyor's Michigan License No. 18658