

SURVEY & REMONUMENTATION

MAR 13 2000

SECTION

JACKSON COUNTY APPROVED LAND CORNER
P.A. 347 of 1990

Chairman Dean R. Galkowski Northeast Corner of Section 9, Hanover Township
LAND CORNER RECORDATION CERTIFICATE
Filing Requirement of Act 74, Mich. P.A. 1970

Date Nov. 10, 1999

For corners in JACKSON (County) Located In: Corner Code #

1. Public Land Survey	T4S R2W	G-3
	T___ R___	_____
	T___ R___	_____
	T___ R___	_____
2. Property Controlling in Section	S___ T___ R___	_____
	S___ T___ R___	_____
3. Miscellaneous Property in Sec.	S___ T___ R___	_____
	S___ T___ R___	_____
4. Lot No. _____, Recorded Plat _____		
5. Private Claims _____		



2138072
Page: 1 of 1
11/24/1999 02:42P
L-1618 P-11

Register of Deeds Stamp & File Number

1	A	B	C	D	E	F	G	H	I	J	K	L	M
2	6	5	4	3	2	1							
3													
4	7	8	9	10	11	12							
5													
6	18	17	16	15	14	13							
7													
8	19	20	21	22	23	24							
9													
10	30	29	28	27	26	25							
11													
12	31	32	33	34	35	36							
13													

I, David E. Erickson, in a field survey on April 24, 1998, do hereby certify that under requirements of P.A. 74, Michigan P.A. of 1970, the corner points mentioned in lines 1 and 2 above were in conformance with regulations and rules therefore as required in the current manual of survey instructions of the United States Department of the Interior, Bureau of Land Management or by a decree of a Court of Law and/or that the corner points mentioned in lines 3, 4 and 5 above were in conformance with the rules of the Michigan Board of Land Surveyors or by a Decree of a Court of Law; established, re-established, monumented, re-monumented, recovered, found as expressed below:

NOTE: Not more than 4 corners, all in the same town and range, may be recorded on this certificate.

A. Description of original monument and accessories and/or subsequent restoration:

In 1825, R. Clark Jr. - Deputy Surveyor, set a "Post" and lists two witnesses: "W. Oak 8 S45°W 32" (21.12') and "W. Oak 10 N6°E 49" (32.34').

In 1886, H.F. Bean, recorded the corner as "Found Cedar Post, has been kept up" and lists two witnesses: "Br. Oak 18" N6°E 48 1/2" (32.01') and "Br. Oak 10" S34 1/2°E 6 1/2" (4.29').

A Land Corner Recordation Certificate (LCRC) by R.E. Gutekunst - RLS #7863, recorded in Liber 2, Page 61 dated 3-31-72 lists the corner as "Found fire clay and one witness standing and stump of another" and lists four witnesses: "S34°E 36" Oak 4.9', North+ 24" Oak 74.4', East+ 15" Hickory 46.87', South+ 24" Oak 42.05' "

B. Description of corner evidence found and/or method applied in restoring or reestablishing corner:


Found bottom 12" of Fire Clay (F.C.) at intersection of tree rows. A 3/4" iron pipe capped "REG 7863" was on the North side of F.C. No brick or crockery found around F.C. Accepted found F.C. as a careful and faithful perpetuation of the original corner. Replaced Fire Clay with a Standard Jackson County Harrison Monument. Buried F.C. and iron pipe on North side of Monument.

C. Description of monument for corner and accessories established to perpetuate locating the position of the corner:

Set standard Harrison monument with cap stamped "G-3 #29245".

N 12° E	Set nail and tag #29245, West side 12" Black Cherry	8.76'
East	Set nail and tag #29245, North side 24" Hickory	46.78'
S 06° W	Set nail and tag #29245, West side 36" Oak	41.98'
S 77° W	Set nail and tag #29245, North side 12" Black Cherry	5.55'
S 43° E	+4' diameter stump	4.90'
North	County Surveyor sign post	1.0'

NOTE: Bearings are magnetic

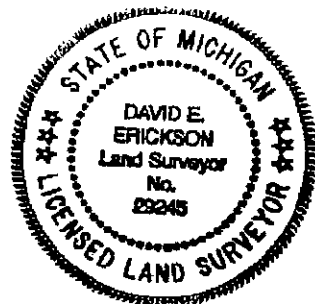

Signed by David Erickson Date 10-12-99

Surveyor's Michigan License No. 29245