

Chairman Dean Substanski
 Date Dec. 30, 1994

LAND CORNER RECORDATION CERTIFICATE
 Filing Requirement of Act 74, Mich. P.A. 1970

For corners in Jackson (County)	Located In:	Corner Code #
1. Public Land Survey	T 4 S R 2 W,	K-4
	T _____ R _____	_____
	T _____ R _____	_____
	T _____ R _____	_____
2. Property Controlling in Section	S _____ T _____ R _____	_____
	S _____ T _____ R _____	_____
3. Miscellaneous Property in Section	S _____ T _____ R _____	_____
	S _____ T _____ R _____	_____
4. Lot No. _____, Recorded Plat _____		
5. Private Claims _____		

STATE OF MICHIGAN
 JACKSON COUNTY
 RECORDED

2 MAY 95 9:20 A.M.

GERALD J. McDEVITT
 REGISTER OF DEEDS

Register of Deeds Stamp & File Number

	A	B	C	D	E	F	G	H	I	J	K	L	M
2	6		5		4		3		2		1		
3													
4	7		6		9		10		11		12		
5													
6	18		17		16		15		14		13		
7													
8	19		20		21		22		23		24		
9													
10	30		29		28		27		26		25		
11													
12	31		32		33		34		35		36		
13													

Timothy B. Van Gieson, in a field survey on November 17, 1994, do hereby certify that under requirements of P.A. 74, Michigan P.A. of 1970, the corner points mentioned in lines 1 and 2 above were in conformance with regulations and rules therefore as required in the current manual of survey instructions of the United States Department of the Interior, Bureau of Land Management or by a decree of a Court of Law and/or that the corner points mentioned in lines 3, 4 and 5 above were in conformance with the rules of the Michigan Board of Professional Surveyors or by a Decree of a Court of Law; established, re-established, monumented, re-monumented, recovered, found as expressed below:

NOTE: Not more than 4 corners, all in the same town and range, may be recorded on this certificate.

A. Description of original monument and accessories and/or subsequent restoration:

- 4: Original government survey dated: 1825
 "Wood Post" "40.00 ch. (2,640.00') 1/4 section post"
 Black Oak 20" N 14° W 35 links (23.10')
 White Oak 18" S 63° E 72 links (47.52')
- 4: Remonumentation survey dated: 1886
 "Stone" "Stone corner and one witness. Set fire clay 2 rods (33.00') West."
 White Oak 24" "West" 64 links (42.24')
 White Oak 12" S 88-1/2° E 61-1/2 links (40.59')
- 4: Nothing recorded in P.A. 74 \$ 2.00 REMONUMENTATION


B. Description of corner evidence found and/or method applied in restoring or reestablishing corner:

- 4: No original government (1825) or remonumentation (1886) accessory trees left standing. Fire clay witness corner found standing November 01, 1972 by Richard E. Gutekunst (R.L.S. No. 7863) and referenced as:
 "Fire clay with capped iron on N.E. side & 2.55' South of old garage" (no longer standing) iron 2.4'± West & 1.0'± South (did not recover)
 "West" 15" Oak 45.95' (no longer standing)
 "South" 26" Oak 101.30' (still standing now 36"±)
 "East" 6" steel post filled with concrete 66.33' (still standing) 2.00 CORNER REMONUMENTATION
 Recovered fire clay witness corner from two standing accessories. Hand dug 3' x 3' pit 33.00' East of said fire clay. Found granite stone measuring 6" thick x 9" wide x 20" long 2.3'± below existing asphalt surface. Accepted stone as faithful and careful perpetuation of corner found in 1886. Found stone to be 33.3'± East of fire clay. Held stone position (North-South) and adjusted (East-West) to 33.00' East of fire clay witness corner. Set standard monument and left stone on South side.

C. Description of monument for corner and accessories established to perpetuate locating the position of the corner:

- 4: 4" x 36" concrete monument with aluminum cap R.L.S. No. 24621

- N 31° E 60-d in West side of 27" Oak 81.35'
- N 66° E 60-d in South side of 15" Oak 32.22'
- S 15° W 60-d in East side of 36" Oak 104.08'
- S 90° W 60-d in South side of 12" Maple 30.00'
- S 90° W fire clay witness corner 33.00'
- N 24° W 60-d in East side of 22" Cherry 60.00'

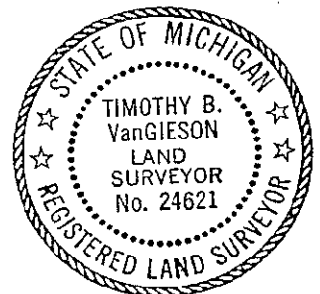

SURVEY &
 REMONUMENTATION

Signed by Timothy B. Van Gieson

MAY 23 1995

December 28, 1994

Surveyor's Michigan License No. 24621