

JACKSON COUNTY
APPROVED LAND CORNER
P.A. 345 of 1990

SOUTHWEST CORNER, SECTION 31
 FULASKI TOWNSHIP

LAND CORNER RECORDATION CERTIFICATE
Filing Requirement of Act 74, Mich. P.A. 1970

#2037908
 Liber 1544 Page 377
 Page 1 of 2
 Jackson Co., MI
 Recorded
 06/11/97 11:33A
 Mindy Reilly
 Register of Deeds

Acting Chairman David Erickson
 Date 6-11-97

For corners in
JACKSON
 (County)

Located In: Corner Code #

**SURVEY &
 REMONUMENTATION**

APR 07 1998

SECTION

Register of Deeds Stamp & File Number

- | | | |
|------------------------------------|---------------------------|-------------|
| 1. Public Land Survey | T <u>4</u> S R <u>3</u> W | <u>A-13</u> |
| | T _____ R _____ | _____ |
| | T _____ R _____ | _____ |
| | T _____ R _____ | _____ |
| 2. Property Controlling in Section | S _____ T _____ R _____ | _____ |
| | S _____ T _____ R _____ | _____ |
| 3. Miscellaneous Property in Sec. | S _____ T _____ R _____ | _____ |
| | S _____ T _____ R _____ | _____ |

4. Lot No. _____, Recorded Plat _____
 5. Private Claims _____

	A	B	C	D	E	F	G	H	I	J	K	L	M
2	6	5	4	3	2								
3													
4	7	8	9	10	11	12							
5													
6	18	17	16	15	14	13							
7													
8	19	20	21	22	23	24							
9													
10	30	29	28	27	26	25							
11													
12	31	32	33	34	35	36							

DEAN R. GUTEKUNST in a field survey on July 17, 1995 & May 28, 97
 do hereby certify that under requirements of P.A. 74, Michigan P.A. of 1970, the corner points mentioned in lines 1 and 2 above were in conformance with regulations and rules therefore as required in the current manual of survey instructions of the United States Department of the Interior, Bureau of Land Management or by a decree of a Court of Law and/or that the corner points mentioned in lines 3, 4 and 5 above were in conformance with the rules of the Michigan Board of Land Surveyors or by a Decree of a Court of Law; established, re-established, monumented, re-monumented, recovered, found as expressed below:

NOTE: Not more than 4 corners, all in the same town and range, may be recorded on this certificate.


A. Description of original monument and accessories and/or subsequent restoration:

Original Government Post set by Joseph Wampler, Deputy Surveyor, 1823.

E. Oak 18" N 8 E 92 links (60.72')
 E. Oak 24" S 55 W 127 links (83.82')

No perpetuation found for the 1880's.

Not recorded in P. A. -74 in Jackson County.

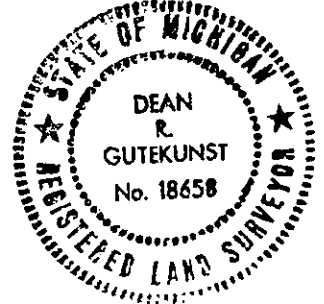

B. Description of corner evidence found and/or method applied in restoring or reestablishing corner:

Jackson County Road Commission excavation of the area, July 17, 1995, by backhoe 7' X 12' X 6' deep, at the intersection of the roads did not recover any evidence of the original corner. Also present, Donald J. Davis, RLS #17617, of Calhoun County.

On October 25, 1996, Donald J. Davis, LPS #17617, the Calhoun County Representative, set a Berntsen monument and a monument box, for the Southeast corner of Section 36, Town 4 South, Range 4 West, Homer Township. His Calhoun County Remonumentation LCRG recorded in Liber 1899, Page 612, Calhoun County Records, states that he used old boundary markers of old cemetery in Section 31 of Scipio (Pulaski) Township, Jackson County to establish the location East & West and all occupation in Sections 36 & 35 of Homer Township (Calhoun County) to establish location North & South. Occupation of land in Section 31 & 30 of Scipio (Pulaski) Township, Jackson County, matched good for location.

Continued on back,

C. Description of monument for corner and accessories established to perpetuate locating the position of the corner:

A-13 T4S, R3W Corner is a 2 1/2" diameter X 30" Berntsen monument with a 3/4" brass cap stamped LS 17617, which is the standard monument for Calhoun County.

- | | | |
|---------|--|--|
| N 45° E | Southwest corner block foundation house #15998 | 100.35' |
| N 20° W | 37" W. Oak | 57.55' Calhoun County nail & tag in Northeast side. |
| N 25° E | 31" Willow | 78.19' Calhoun County nail & tag in West side in root. |
| N 80° E | 9" Cedar | 79.65' Calhoun County nail & tag in South side. |
| S 23° W | 34" Red Oak | 54.54' Calhoun County nail & tag in Southeast side. |
| S 53° E | 32" Maple | 43.43' Pole barn spike and washer in Northeast side. |
| N 40° W | 41" Oak | 27.82' Pole barn spike and washer in Southwest side. |

Signed by Dean R. Gutekunst

Date June 1, 1997

Surveyor's Michigan License No. 18658