

For corners in
JACKSON
 (County)

Located In:

Corner Code #

1. Public Land Survey

T 4S R 3W

M-6



Mindy Reilly - Jackson Co.

CORREM

2104467

Page: 1 of 1

02/10/1999 10:51A

L-1593 P-261

2. Property Controlling
 in Section

S T R

3. Miscellaneous
 Property in Sec.

S T R

S T R

Register of Deeds Stamp & File Number

4. Lot No. , Recorded Plat

5. Private Claims

1	A	B	C	D	E	F	G	H	I	J	K	L	M
2	6	5	4	3	2	1							
3													
4	7	8	9	10	11	12							
5													
6	18	17	16	15	14	13							
7													
8	19	20	21	22	23	24							
9													
10	30	29	28	27	26	25							
11													
12	31	32	33	34	35	36							
13													

I, David E. Erickson, in a field survey on April 27, 19 98, do hereby certify that under requirements of P.A. 74, Michigan P.A. of 1970, the corner points mentioned in lines 1 and 2 above were in conformance with regulations and rules therefore as required in the current manual of survey instructions of the United States Department of the Interior, Bureau of Land Management or by a decree of a Court of Law and/or that the corner points mentioned in lines 3, 4 and 5 above were in conformance with the rules of the Michigan Board of Land Surveyors or by a Decree of a Court of Law; established, re-established, monumented, re-monumented, recovered, found as expressed below:

NOTE: Not more than 4 corners, all in the same town and range, may be recorded on this certificate.

A. Description of original monument and accessories and/or subsequent restoration:

In 1823, J. Wampler - Deputy Surveyor, set a "Post" and recorded two witnesses: "W. Oak 7, S45°W, 4" (2.64') and "do 10, N28°W, 103" (67.98').

This corner not recorded under Act #74.

B. Description of corner evidence found and/or method applied in restoring or reestablishing corner:

Found 1/4" x 18" rebar at surface, disturbed and leaning Northerly, 6' East of gravel road centerline. Excavated area with backhoe. Dug 3' deep into native soil, 5' North, 15' South (to cover fencerow East) 8' East, and 16' West of found rebar. No other evidence of corner found. Declared corner position "Lost" and Re-established by single proportionate measure. (This position is 0.24' South of disturbed rebar, which was likely set at the midpoint.) Set a standard Jackson County Harrison Cast Iron Monument midway on line between remonumented corners M-5 and M-7.


C. Description of monument for corner and accessories established to perpetuate locating the position of the corner:

Set standard Jackson County Harrison Cast Iron Monument stamped "M-6, #29245".

N 79° E	Set Nail & Tag #29245 in North side 36" Oak	22.08'
S 33° E	Set Nail & Tag #29245 in West side 30" Oak	46.09'
S 7° W	Set Nail & Tag #29245 in East side 26" Oak	388.27'
S 87° W	Set Nail & Tag #29245 in North side Power Pole	180.73'
West	County Surveyor sign post	28.0'

Note: Bearings are magnetic.

N01°45'25"E	Corner M-5 as remonumented	2646.13'
S01°45'25"W	Corner M-7 as remonumented	2646.13'

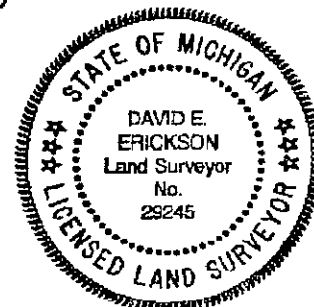

Signed by David Erickson Date 2-9-99

Surveyor's Michigan License No. 29245