

LAND CORNER RECORDATION CERTIFICATE
Filing Requirement of Act 74, Mich. P.A. 1970

For corners in


<u>Kalkaska</u> (County)	Located In:	Corner Code #
1. Public Land Survey	T <u>25N</u> R <u>6W</u>	<u>B-5</u>
	T _____ R _____	_____
2. Property Controlling in Section	S _____ T _____ R _____	_____
	S _____ T _____ R _____	_____
3. Miscellaneous Property in Sec.	S _____ T _____ R _____	_____
	S _____ T _____ R _____	_____

4. Lot No. _____, Recorded Plat _____

5. Private Claims _____

I, Craig W. McVean, in a field survey on Feb. 17 1998 do hereby state that under requirements of P.A. 74, Michigan P.A. of 1970, the corner points mentioned in lines 1 and 2 above were in conformance with regulations and rules therefore as required in the current manual of survey instructions of the United States Department of the Interior, Bureau of Land Management or by a decree of a Court of Law and for that the corner points mentioned in lines 3, 4 and 5 above were in conformance with the rules of the Michigan Board of Land Surveyors or by a Decree of a Court of Law; established, re-established, monumented, recovered, found as expressed below:

NOTE: Not more than 2 corners, all in the same town and range, may be recorded on this certificate.

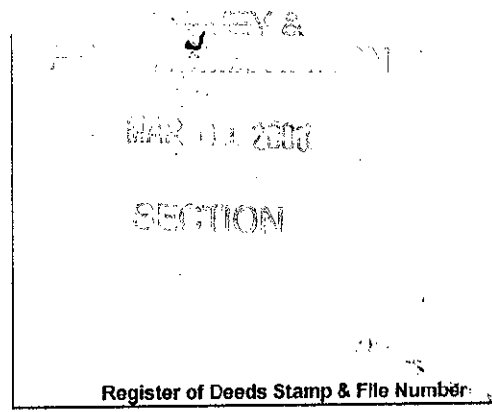

A	B	C	D	E	F	G	H	I	J	K	L	M
1												
2	6	5	4				3	2				
3												
4	7	8	9				10	11	12			
5												
6	18	17	16	15	14	13						
7												
8	19	20	21	22	23	24						
9												
10	30	29	28	27	26	25						
11												
12	31	32	33	34	35	36						
13												

A. Description of original monument and accessories and/or subsequent restoration:

- B-5 - GLO - Set 1/4 Post- G.H. Cannon - 1852
 - W. Pine 18" S61°W 38L.
 - W. Pine 24" N30°E 18 L.
 - Fargo Eng. - Caukin - 1912 - Fnd U.S. Wit. & very old stake point under surface - Set Iron & Crockery Monument - Bk 342, P. 17
 - M. Schaaf - 1941 - Fnd. Iron Pipe & both BT stps. NE BT only 17 L.
 - WPS 20" S1 1/2°W 38L.
 - WPS 17" N81°W 15 1/2L.
 - WPS 24" N48°E 75L.
 - K. Ostling - 1955 - Fnd. M.S. Cor. - Set 1" Pipe with 4" Brass Cap. Original BT's in place.
 - 14" R. Pine - West 143 L.
 - 8" Tam. N35°E 36 L.
- LCRC L.2, pg.146
- W.P. Richards - 1978 - Fnd. DOC (DNR) Mon. besided Fargo Pipe.
 - 24"R. Pine N85°E 29.44'
 - 12" Tam N45°E 24.17'
 - 8" J. Pine S60°E 14.18'
- LCRC L.2 P.275
- C.F. Rose, r - 1981 - Fnd. Dept. Mon. & Fargo pipe
 - N42°E 24.17' 12" Tam.
 - N82°E 29.35' 29" R. Pine
 - S47°W 14.16' 8" J. Pine
 - N85°W 94.3' 17" R. Pine

B. Description of corner evidence found and/or method applied in restoring or reestablishing corner:


B-5 - 1/4 Corner common to Sec. 7 & 18, T25N, R6W- Fnd. 1 1/4" O.D. x 2.3' long hook end Fargo Pipe with 4" DOC (DNR) Mon. on 1" pipe on N. Side. Removed both Pipes & dug down. Fnd. broken Butter Dish & and old Cedar Post bottom on SW side of Fargo Pipe. Reset 4" DOC Brass Cap on 1" x 3.5' long Iron Pipe at Fargo pipe position. Reset Butter Dish & Post Bottom at SE base of Pipe. Reset 4" x 4" Cedar Post scribed 1/4 -0.4' NE. Newer Cedar Post is 1.2' SE (face). DOC (DNR) Monument accepted as a careful & faithful perpetuation of the position of the original corner.

C. Description of monument for corner and accessories established to perpetuate locating the position of the corner:

- B-5 - 4" DOC (DNR) Brass Cap on 1" x 3.5' Iron Pipe
 - N76°E 29.31' to set N&T in S. side 31" R. Pine scribed 'XBT' (WPR, CFR)
 - S40°W 14.09' to set N&T in SE side 10" J. Pine (CFR)
 - S55°E 30.75' to set N&T in SW side 16" R. Pine scribed 'XBT'
 - S81°W 27.49' to set N&T in S side 10" W. Pine scribed 'XBT'
 - N57°W 12.30' to set N&T in SW side 10" W. Pine scribed 'XBT'
 - Set Blue Carsonite Post 1' N.

Signed by Craig W. McVean
 Surveyor's Michigan License No. 39088

Date 12/9/1999

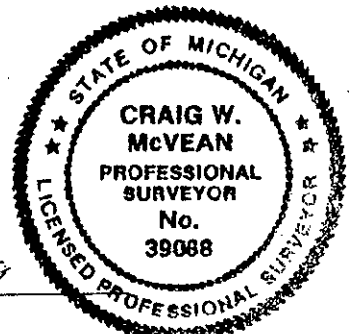

Ratified by Peer Group
 P.A. 345 - 1990 Kalkaska County
 Chairman [Signature]
 Date 9-14-99

FI 3019494
 Page: 1 of 1
 12/23/1999 10:58A
 REMON
 LB: B PG: 50
 Kalkaska County Joan Hall, Register