


**LAND CORNER RECORDATION CERTIFICATE**  
**Filing Requirement of Act 74, Mich. P.A. 1970**

For corners in

<u>KALKASKA</u> (County)	Located In:	Corner Code #
1. Public Land Survey	T 25N R 6W	C-2
2. Property Controlling in Section	S _____ T _____ R _____	_____
3. Miscellaneous Property in Sec.	S _____ T _____ R _____	_____

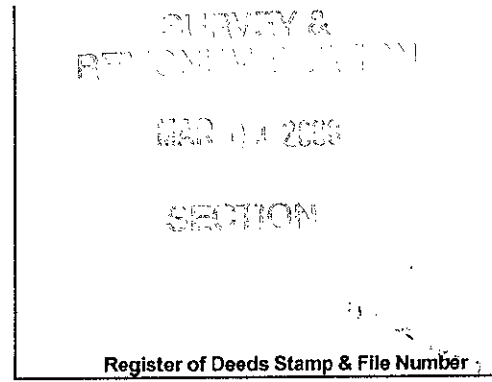

4. Lot No. \_\_\_\_\_, Recorded Plat \_\_\_\_\_

5. Private Claims \_\_\_\_\_

I, Craig W. McVean, in a field survey on Sept. 23 1999 do hereby state that under requirements of P.A. 74, Michigan P.A. of 1970, the corner points mentioned in lines 1 and 2 above were in conformance with regulations and rules therefore as required in the current manual of survey instructions of the United States Department of the Interior, Bureau of Land Management or by a decree of a Court of Law and /or that the corner points mentioned in lines 3, 4 and 5 above were in conformance with the rules of the Michigan Board of Land Surveyors or by a Decree of a Court of Law; established, re-established, monumented, recovered, found as expressed below:

**NOTE: Not more than 2 corners, all in the same town and range, may be recorded on this certificate.**

	A	B	C	D	E	F	G	H	I	J	K	L	M
1													
2	6		5		4		3		2		1		
3													
4	7		8		9		10		11		12		
5													
6	18		17		16		15		14		13		
7													
8	19		20		21		22		23		24		
9													
10	30		29		28		27		26		25		
11													
12	31		32		33		34		35		36		
13													

**A. Description of original monument and accessories and/or subsequent restoration:**

<u>C-2</u> - GLO - G. Cannon - 1852 - Set 1/4 Post Beech 12" S65°W 44 L. Beech 7" N77°E 19 L. - W. Merrill - 1911 - Dist N&S from corner - Fargo Eng. - 1912 - No U.S. Witness - Fnd. iron & Accepted, No Witness taken - LCRC - L. 2, P. 147 - W. P. Richards-1978 1/2" Iron Pipe fnd. & used by T. Tulier (A.Erickson) & perpetuated with Conc. Mon. 1960. SW cor. Hse. N45°E 78' 5" Maple N45°W 51.35', Fence line W. -Rec. Sur. L.1, P.793-1975,L.2, P. 268-1975 -Consumers P.C. - D.A. Ankrom - 1979- 5/8" Rod in Conc. 10" R. Pine N7°W 26.35' 12" Quad Maple N44°W 51.56' 4" Oak S33°W 88.95'	-LCRC - L. 2, P. 289 - R. Mitchell - 1988 Fd. Conc. Mon., N49°E 10" R. Pine 38.00' N11°W 10" R. Pine 26.15' N50°W Maple Clump 51.38' W. 6" Twin Oak 57.65' - LCRC - L. 2, P. 391 - B.M. Jones - 1989 - Conc. Mon. N45°W 36" Maple 51.50' N6°W 12" R. Pine 26.25' N62°E 12" W. Pine 49.55' S11°E 10" Oak 133.20'
---	--


**B. Description of corner evidence found and/or method applied in restoring or reestablishing corner:**

C2- 1/4 Corner common to sec. 5&6 -found concrete Mon. w/ 1/2" iron on shoulder of road curve S & E. SE'ly 46'± to CL gravel rd. curve. Conc. mon. is apparent perpetuation of Merrill & Fargo position-Fits their surveys. Concrete mon. accepted as the best available evidence of the position of the original corner.

**C. Description of monument for corner and accessories established to perpetuate locating the position of the corner:**

C2- Concrete mon. w/ 1/2" iron  
Set blue Carsonite post 1' N.  
N65°E 48.11' to set Nail & Tag in S.E. side 20" White Pine (BMJ)  
N 54°E 37.97' to set N & T in S.E. side 18" Red Pine (RM)  
N15°W 26.11' to set N & T in W. side 17" Red Pine (CPC,BMJ,RM)  
N46°W 51.24' to set N & T in NE. side 18" Sugar Maple Clump-4 (WPR,CPC,BMJ,RM)  
N86°W 57.68' to set N & T in N. side 17" Red Oak (BMJ)  
N68°E 154.81' to SE. corner block foundation house # 5025

Signed by Craig W. McVean Date 12/9/1999  
 Surveyor's Michigan License No. 39088

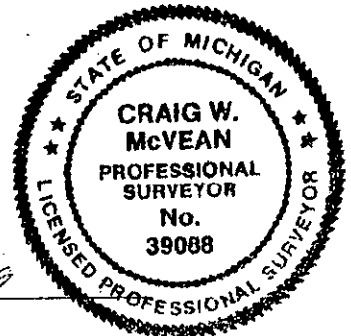

Ratified by Peer Group  
 P.A. 345 - 1990 Kalkaska County  
 Chairman Joan Hall  
 Date 9-14-99