

LAND CORNER RECORDATION CERTIFICATE

Filing Requirement of Act 74, Mich. PA 1970

For Corners In: KALKASKA Located In _____ Corner Code # _____
(County)

1. Public Land Survey		T <u>25N</u>	R <u>6W</u>	C <u>4</u>
		T _____	R _____	_____
2. Property Controlling in Section	S _____	T _____	R _____	_____
	S _____	T _____	R _____	_____
3. Miscellaneous Property in Section	S _____	T _____	R _____	_____
	S _____	T _____	R _____	_____


4. Lot No: _____ Recorded Plat: _____

5. Private Claims: _____

I, Craig W. McVean, in a field survey on Sept. 20, 1999 do hereby state that under requirements of PA 74, Michigan PA of 1970, the corner points mentioned in lines 1 and 2 above were in conformance with regulations and rules therefore as required in the current manual of survey instructions of the United States Department of the Interior, Bureau of Land Management or by a decree of a Court of Law and/or that the corner points mentioned in lines 3, 4 and 5 above were in conformance with the rules of the Michigan Board of Land Surveyors or by a Decree of a Court of Law; established, re-established, monumented, recovered, found as expressed below:

NOTE: Not more than 2 corners, all in the same town and range, may be recorded on this certificate.

Register of Deeds Stamp & File Number

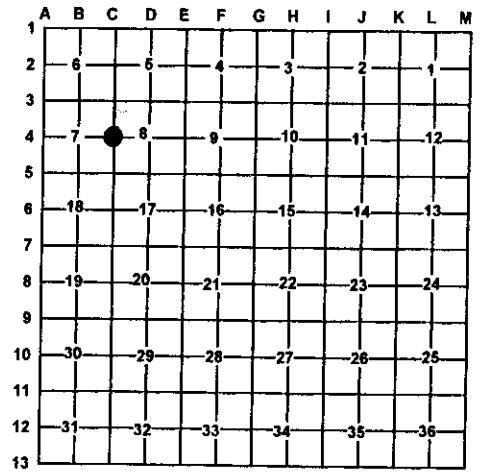

A. Description of original monument and accessories and/or subsequent restoration:

- C4-GLO-Set post- G. Cannon-1852 -LCRC L. 2,P. 226-C.F.Roser-1981-Set 5/8" X 36" rebar 33' east of fnd. conc. ROW mon. per Richards. 12" J. Pine N55°E 65.44', 14" J. Pine S53°E 56.81', 8" J. Pine S55°W 61.21', 12" Cherry(Clp.) N62°W 81.89', Added Cedar Post next to ROW Mon.
- Sp. Pine 6" N44E 32 L., Sp. Pine 8" S36°W 14 L.
- E. Mosher-1884-Rd. Survey -DNR survey proj # 31-93113-1982
- W.S. Merrill-Dist. N & S-1911
- Fargo Eng.- Caukins-1912 -Fnd. GLO Sp. Pine Stp. -Set Iron & Crockery Mon.- W. Pine 14" S74°30'W 117.5L.
- Rec. Sur.-L.1, P.783-785-1975- W. Richards- Tuller's 1/2" Iron Rod found.

B. Description of corner evidence found and/or method applies in restoring or re-establishing corner:

C4- 1/4 corner common to Sections 7 & 8- Fnd. Capped 5/8" rebar per record LCRC by Roser. Removed capped 5/8 X 36" rebar and dug down 1.5' & found 1/2" X 18" rebar w/ wood stake under Roser position. Irons in CL of N-S gravel road - no evidence of Fargo monument found. Irons fits Fargo distance N&S. Rebars accepted as the best available evidence of the position of the original corner.

C. Description of monument for corner and accessories established to perpetuate locating the position of the corner:

C-4 - Replaced Rebar w/ 3" Kalkaska Co. Remon. Brass cap on 5/8" X 34" Rebar, add coffee can w/ conc. around B.C. - down 0.6' West 32.99' to conc. mon. w/ 1/2" iron & cedar post w/ loc. tag S68°W 51.39' to set N&T in S. side 8" J. Pine scribed 'XBT' N68°W 83.72' to set N&T in N. side 11" Cherry in clp. (CFR) N42°W 90.36' to set N&T in SW side 8" R. Pine N80°E 37.83' to set N&T in S side 5" J. Pine scribed 'XBT' S48°W 61.23' to set N&T in SE side 12" J. Pine (CFR)



Signed by: Craig W. McVean
Surveyor's Michigan License No.: 39088

Date: 12/9/1999