

LAND CORNER RECORDATION CERTIFICATE

Filing Requirement of Act 74, Mich. PA 1970

For Corners In: KALKASKA Located In _____ Corner Code # _____
(County)

1. Public Land Survey		T <u>25N</u>	R <u>6W</u>		<u>E-3</u>
		T _____	R _____		
2. Property Controlling in Section	S _____	T _____	R _____		
	S _____	T _____	R _____		
3. Miscellaneous Property in Section	S _____	T _____	R _____		
	S _____	T _____	R _____		


4. Lot No: _____ Recorded Plat: _____

5. Private Claims: _____

I, Craig W. McVean, in a field survey on Jan. 7, 1998 do hereby state that under requirements of PA 74, Michigan PA of 1970, the corner points mentioned in lines 1 and 2 above were in conformance with regulations and rules therefore as required in the current manual of survey instructions of the United States Department of the Interior, Bureau of Land Management or by a decree of a Court of Law and/or that the corner points mentioned in lines 3, 4 and 5 above were in conformance with the rules of the Michigan Board of Land Surveyors or by a Decree of a Court of Law, established, re-established, monumented, recovered, found as expressed below:

NOTE: Not more than 2 corners, all in the same town and range, may be recorded on this certificate.

Register of Deeds Stamp & File Number

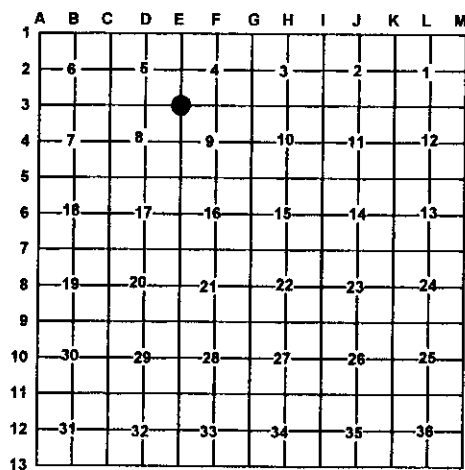

- A. Description of original monument and accessories and/or subsequent restoration:**
- E-3 - GLO - G. Cannon - 1852 - Set Post
 - Y. Pine 20" N45°E 27 L.
 - Y. Pine 14" S25°W 38 L.
 - E. Mosher - Rd. Survey Tie - 1888
 - Fargo Eng. - Bk.342, P.10 - 1912 - Fnd. stake & both U.S. trees
 - Y. Pine N45°E 27 L.
 - Y. Pine S23°W 34 1/2 L.
 - Set iron & Crockery Mon.
 - M. Schaaf - 1940 - Fnd. both BT stp. in place but SW is 3 L. short of Record. Corner checks strn. S&W. Iron Post sets at corner.
 - Y. Pine 18" N48°W 28 1/2 L.
 - W. Pine stp. 26" N24°E 1.09 L.
 - W. Pine stp. 40" S75 1/2°E 39 L.
 - K. Ostling 1956- Fnd. Schaaf cor. Set 1" Pipe with 4" Brass cap
 - 18" R. Pine N87°W 83 L.
 - 10" W. Oak S44°E 61.5 L.
 - LCRC - L. 2, P. 1 - M. McClung - 1974 - Fnd. DNR Cor.
 - 18" R. Pine N87°W 55.33'
 - 10" W. Oak S44°E 41.0'
 - LCRC - L.2, P.144 - W.P. Richard - 1978 - DNR Mon. beside Fargo Iron.
 - 16" N. Pine N82°W 54.90'
 - 10" N. Pine N5°E 35.20'
 - 14" Oak S41°E 41.10'
 - Consumers P.C. - D.A. Ankrom - Fnd. Mi. Dept. of Cons. 3" Brass Cap over 1" Pipe.
 - 6" R. Pine N50°E 28.73'
 - 20" W. Oak S35°E 41.02'
 - 20" R. Pine N85°W 55.23'
 - 10" W. Pine N5°E 35.21'
 - LCRC - L.2, P.227 - 1981 - C.F. Roser - Fnd. DNR Mon. - Add Cedar Post.
 - 7" R. Pine N53°E 28.71'
 - 20" Oak S38°E 41.00'
 - 20" R. Pine N82°W 55.00'

B. Description of corner evidence found and/or method applies in restoring or re-establishing corner:

E-3 - Section Corner common to Sections 4,5,8, & 9, T25N, R6W- Found 1" O.D. x 2.2' long Iron Pipe with hook end with 3 Pieces of broken crockery at base per Fargo Eng. Also fnd. DOC (DNR) Mon. along side. Removed Fargo Pipe & reset 4" DOC (DNR) Brass Cap on 1" I.D. x 3.5' Iron Pipe at Fargo Position. Placed broken Crockery at base of Pipe. Both remains of GLO BT's are in place as noted by Fargo & Schaaf. Remains of Schaaf witness BT's in place. DOC (DNR) Monument accepted as a careful & faithful perpetuation of the position of the original corner.

C. Description of monument for corner and accessories established to perpetuate locating the position of the corner:

E-3 - 4" DOC(DNR) Brass Cap on 1" I.D. x 3.5' long Iron Pipe
 N48°E 28.80' to set N&T in NW side 12" R. Pine scribed 'XBT'
 N86°W 55.51' to set N&T in S side 22" R. Pine scribed 'XBT' (MM,KO,CFR,CPC)
 S44°E 41.22' to set N&T in NE side 24" W. Oak (MM, CFR, KO, CPC)
 North 35.24' to set N&T in W side 14" W. Pine scribed 'XBT' (WPR, CPC)
 N86°E 14.45' to set N&T in N side 4" W. Pine scribed 'XBT'
 Set Blue Carsonite Post 1' N
 WNW 0.55' to face of Cedar Post



Signed by: Craig W. McVean
 Surveyor's Michigan License No.: 39088

Date: 12/9/1999