

LAND CORNER RECORDATION CERTIFICATE


Filing Requirement of Act 74, Mich. PA 1970

For Corners In: <u>Kalkaska</u> (County)	Located In T <u>25N</u> R <u>6W</u>	Corner Code # <u>D2</u>	
1. Public Land Survey	T _____ R _____	_____	_____
2. Property Controlling in Section	S _____ T _____ R _____	_____	_____
3. Miscellaneous Property in Section	S _____ T _____ R _____	_____	_____
4. Lot No: _____	Recorded Plat: _____		
5. Private Claims: _____			

Register of Deeds Stamp & File Number

I, Craig W. McVean, in a field survey on September 23, 1999 do hereby state that under requirements of PA 74, Michigan PA of 1970, the corner points mentioned in lines 1 and 2 above were in conformance with regulations and rules therefore as required in the current manual of survey instructions of the United States Department of the Interior, Bureau of Land Management or by a decree of a Court of Law and/or that the corner points mentioned in lines 3, 4 and 5 above were in conformance with the rules of the Michigan Board of Land Surveyors or by a Decree of a Court of Law; established, re-established, monumented, recovered, found as expressed below:

NOTE: Not more than 2 corners, all in the same town and range, may be recorded on this certificate.

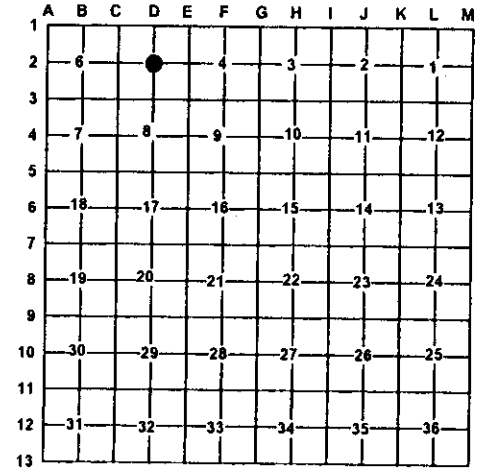

A. Description of original monument and accessories and/or subsequent restoration:

- D-2 - W.S Merrill- 1911- Survey Sec.5 notes - indicate corner was set.
- Richard, Findorff, Richards - 1968 - found iron pipe.
- Consumers Power Co. - drawing # SF 17406-D.A. Ankrom-1979 set capped 1/2" rebar at intersection of 1/4 lines
- LCRC L.2, p, 288-1986- R. Mitchell-fnd. 1" iron pipe in centerline of E-W. gravel Rd. Accepted as Merrills 1911 corner, S37°E 6" W. Pine 38.13', S26°W 6" W.Pine 28.01', S41°W 6"W.Pine 26.22', S5°W 1/2" rerod cap #21265-11.95'
- LCRC L.2 P.391-B.M. Jones- 1989-fnd. 1" pinch pipe. N83°E PP 112.5', S32E 6" W.Pine 38.10', S32°W 6" W. Pine 28.00', S43°W 6" W.Pine 26.20'

B. Description of corner evidence found and/or method applies in restoring or re-establishing corner:

- D-2 - C1/4 Sec.5 - fnd. 1" O.D. iron pipe - down 1'+ in CL. E-W gravel Rd. as recorded by Mitchell & Jones, also found a 3/4" iron rod S45°E 0.9' of pipe - no record of usage on 3/4" iron rod. Field line to North. Iron pipe fits line of monumentation from C2 to cor# 9. (E1/4 cor. (E2) is in the river) apparently set by Merrill's 1911 Survey. Iron pipe accepted as the best available evidence of the position of the corner.
- Ref. Pt. - Fnd. CPC 1/2" Capped iron S5°01'40"W 12.00' from D-2. Ankrom set at calculated intersection of 1/4 lines. This position could not be accepted as D-2 since Merrill's position had long since been recognized and used as D-2.

C. Description of monument for corner and accessories established to perpetuate locating the position of the corner:

- D-2 - 1" O.D. Iron pipe- added 2" alum. cap on 1/2" X 6" Rebar into center of pipe. Placed 4" X 1' PVC W/ conc. around 2" A.C. - down 0.6'
 North 33.03' to 1/2" Cir #28432-31611
 South 33.01' to 1/2" Cir # 24594
 S36°E 38.19' to set N&T in NE side 9" W.Pine (RM,BJ)
 S42°W 26.11' to set N&T in NE Side of 9" W. Pine (RM,BJ)
 S26°W 28.00' to fnd. Nail in NW. side 8" W.Pine (RM,BJ)
 S5°01'40"W 12.00' to capped 1/2" rebar #21265 - Ref. Pt.



Signed by: Craig W. McVean Date: 10/19/2000
 Surveyor's Michigan License No.: 39088