

MICHIGAN  
DEPARTMENT OF CONSERVATION  
FORESTRY DIVISION

LAND CORNER RECORD

T. 25. NR. 6. W. C-5

Ka kaska COUNTY

DESCRIPTION OF CORNER Corner common to Sections 7, 8, 17, 18

DESCRIPTION OF CORNER MONUMENT 1"x24" pipe, below surface of road

WITNESSES TO CORNER 6" J. Pine - N71E - 59 links


20" R. Pine - N53W - 113 1/2 links

DESCRIPTION IN DETAIL AS TO HOW CORNER WAS LOCATED AND IDENTIFIED OR RESTORED.

This corner was found by Forestry Division survey crew while making a partial resurvey of this township. Corner was previously established by Marcus Schaaf, Registered Land Surveyor, in 1941.

Corner was placed and witnessed June 2, 1955/

SURVEYORS SEAL

 

SIGNED Sean C. Schmitt DATE 3/7/56  
REGISTERED LAND SURVEYOR