

MICHIGAN
DEPARTMENT OF CONSERVATION
FORESTRY DIVISION

LAND CORNER RECORD

T. 25 NR. 6 W. ^{K-12}

----- Kalkaska ----- COUNTY

DESCRIPTION OF CORNER 1/4 corner common to Sections 35 & 36 -----

DESCRIPTION OF CORNER MONUMENT 1" pipe with 4" brass cap -----


WITNESSES TO CORNER 14" R. Pine - N12E - 28 links -----

16" Y. Pine stump - S60E - 14 links -----

DESCRIPTION IN DETAIL AS TO HOW CORNER WAS LOCATED AND IDENTIFIED OR RESTORED.

This corner was found by Forestry Division survey crew while making a partial resurvey of this township. Corner was previously established by Marcus Schaaf, Registered Land Surveyor, in 1940, from original BTs, which are still in place.

Corner was placed and witnessed June 2, 1955.

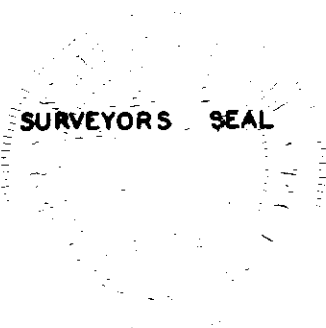

SIGNED Sean C. [Signature] DATE 3/7/56
REGISTERED LAND SURVEYOR