

MICHIGAN  
DEPARTMENT OF CONSERVATION  
FORESTRY DIVISION

LAND CORNER RECORD

T. 25. NR. 6 W.

Kalkaska COUNTY

DESCRIPTION OF CORNER Corner common to Sections 29, 30, 31, 32 <sup>C-11</sup>

DESCRIPTION OF CORNER MONUMENT 1" pipe with 4" brass cap


WITNESSES TO CORNER 5" Elm - S82W - 47 1/2 links

8" Basswood - S25W - 72 1/2 links

DESCRIPTION IN DETAIL AS TO HOW CORNER WAS LOCATED AND IDENTIFIED OR RESTORED.

This corner was found by Forestry Division survey crew while making a partial resurvey of this township. Corner was previously established by Marcus Schaaf, Registered Land Surveyor, in 1941, from original BTs.

Corner was placed and witnessed June 6, 1955.

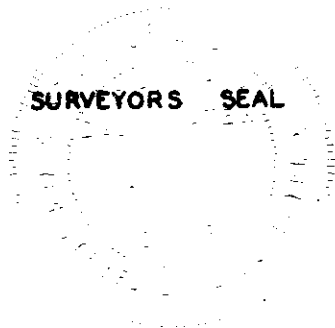

SIGNED Sean C. [Signature] DATE 3/7/56  
REGISTERED LAND SURVEYOR