

MICHIGAN
DEPARTMENT OF CONSERVATION
FORESTRY DIVISION

LAND CORNER RECORD

T. 24 NR 6 W L-1
25 NR 6 W L-12

Kalkaska COUNTY

DESCRIPTION OF CORNER 1/4 corner common to Sections 1 & 36

DESCRIPTION OF CORNER MONUMENT 1"x24" pipe, no cap


WITNESSES TO CORNER 7" W. Oak - S70E - 48 1/2 links

12" B. Oak - N20E - 170 links

DESCRIPTION IN DETAIL AS TO HOW CORNER WAS LOCATED AND IDENTIFIED OR RESTORED.

This corner was found by Forestry Division survey crew while making a partial resurvey of this township. Corner was previously established by Marcus Schaaf, Registered Land Surveyor, in 1940, from original BTs.

This corner was placed and witnessed June 2, 1955.

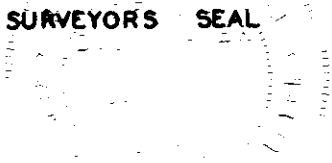

SIGNED *John C. [Signature]* DATE 3/7/56
REGISTERED LAND SURVEYOR