

LAND CORNER RECORDATION CERTIFICATE

FILING REQUIREMENT OF ACT 74, MICH. P.A.1970

FOR CORNERS OF --:	LOCATED IN --:	CORNER CODE NUMBER
1. PUBLIC LAND SURVEY _____	T. 25 ^{N.} S. , R. 6 ^{W.} E.	B-6
2. PROPERTY CONTROLLING IN SECTION 18 _____	T. 25 ^{N.} S. , R. 6 ^{E.} W.	8; 10; 11
3. MISCELLANEOUS PROPERTY IN SECTION _____	T. _____ ^{N.} S. , R. _____ ^{E.} W.	
4. LOT NO. _____, RECORDED PLAT _____		
5. PRIVATE CLAIMS _____		

REGISTER OF DEEDS STAMP AND FILING NUMBER

I, Carl F. Roser, do hereby certify that under requirements of P.A. 74, Michigan P.A. of 1970, the corner points mentioned in lines 1 and 2 above were, in a field survey on January 26, 1981, established, re-established, monumented, re-monumented, recovered or restored as expressed below and in conformance with regulations and rules therefore as required in the current manual of survey instructions of the United States Department of the Interior, Bureau of Land Management or by a decree of a court of law. Furthermore, that the corner points mentioned in lines 3, 4 and 5 above were, in a field survey on _____, 19____, found, recovered, restored, established or re-established as expressed below and in conformance with the rules of the Michigan State Board of Registration for Land Surveyors or, by a Decree of a Court of law:

~~XX~~

C. Continued:

10	11
Set 5/8" x 36" rerod w/R.L.S. cap & ced. post w/Loc tag	Set 5/8" x 36" rerod w/R.L.S. cap & ced. post w/Loc tag
12" W. Pine S22°W 18.7	9" W. Pine S22°E 16.0'
8" W. Pine N55°W 15.8	6" W. Pine S50°E 13.3'
8" Hemlock N43°E 41.7	8" W. Pine N73°E 19.1'

B. Description of corner evidence found and/or method applied in restoring or re-establishing corner:


- B-6 Established center of Sec. 18 at intersection of one-quarter lines.
- 8 Established W 1/8 corner on E-W 1/4 line, Sec. 18, per Std. B.L.M. instructions (pro-rated to G.L.O. survey plat-run out Sec.).
- 10 Established South 1/8 corner on W. line of Sec. 18 equidistant & on line between W 1/4 & SW corner of Sec. 18.
- 11 Established ctr. of frl. SW1/4 of Sec. 18 per std. B.L.M. instructions (pro-rated to G.L.O. survey plat-run out Sec.).

C. Description of monument for corner and accessories established to perpetuate locating the position of the corner:

B-6	8
Set 5/8" x 36" rerod w/R.L.S. cap & ced. post w/Loc tag	Set 5/8" x 36" rerod w/R.L.S. cap & ced. post w/Loc tag
8" Maple S50°E 19.6	8" Maple (clump) N19°W 36.7
5" Maple South 18.4	4" Maple N67°W 17.7
5" Maple S87°W 26.5	4" W. Pine S34°W 29.0

SIGNED BY Carl F. Roser 3-16-81 DATE _____

SURVEYOR'S MICHIGAN REGISTRATION NO. 12028

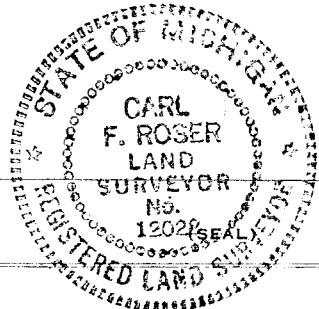

FOR STATE AND UNITED STATES AGENCIES:

SIGNED BY _____ DATE _____
CHIEF OF SURVEY PARTY

APPROVED AND SIGNED BY _____ DATE _____
MICHIGAN REGISTERED LAND SURVEYOR

(SEAL)

GARFIELD TOWNSHIP (Central Part)
KALKASKA COUNTY

SURVEYOR'S MICHIGAN REGISTRATION NO. _____