

LAND CORNER RECORDATION CERTIFICATE
Filing Requirement of Act 74, Mich. P.A. 1970

For corners in
KALKASKA
 (County)

Located In: _____ Corner Code #/# _____

1. Public Land Survey	T <u>25N</u> R <u>6W</u>	<u>L-7, M-7</u>
	T _____ R _____	_____
	T _____ R _____	_____
	T _____ R _____	_____
2. Property Controlling in Section	S <u>13</u> T _____ R _____	<u>13, 14</u>
	S _____ T _____ R _____	_____
3. Miscellaneous Property in Sec.	S _____ T _____ R _____	_____
	S _____ T _____ R _____	_____

Register of Deeds Stamp & File Number

4. Lot No. _____, Recorded Plat _____
 5. Private Claims _____


A	B	C	D	E	F	G	H	I	J	K	L	M
2	6	5	4	3	2	1						
3												
4	7	8	9	10	11	12						
5												
6	18	17	16	15	14	13						
7												
8	19	20	21	22	23	24						
9												
10	30	29	28	27	26	25						
11												
12	31	32	33	34	35	36						
13												

I, C.T. KIISKILA, in a field survey on FEB. 2, 19 95, do hereby certify that under requirements of P.A. 74, Michigan P.A. of 1970, the corner points mentioned in lines 1 and 2 above were in conformance with regulations and rules therefore as required in the current manual of survey instructions of the United States Department of the Interior, Bureau of Land Management or by a decree of a Court of Law and/or that the corner points mentioned in lines 3, 4 and 5 above were in conformance with the rules of the Michigan Board of Land Surveyors or by a Decree of a Court of Law; established, re-established, monumented, re-monumented, recovered, found as expressed below:

NOTE: Not more than 4 corners, all in the same town and range, may be recorded on this certificate.

A. Description of original monument and accessories and/or subsequent restoration:
 L-7 M-7 13

(NO EVIDENCE OF G.L.O. CORNER, B.T.'S, LINE TREES & TOPOGRAPHY, AS CALLED OUT IN THE G.L.O. LINE NOTES; UNLESS NOTED IN ITEM "B" BELOW.)

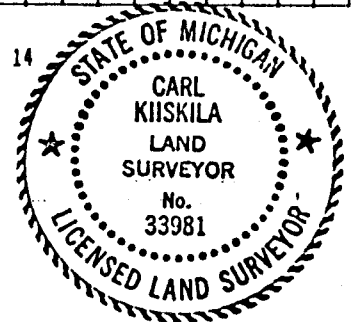

B. Description of corner evidence found and/or method applied in restoring or reestablishing corner:

L-7	M-7	13	14
FD CONSERVATION DEPT MON FOR S1/4 COR SEC 13 AS SET IN 1955 DEPT SURVEY. 1955 DEPT SURVEY FD M.SCHAAF MON AS SET IN 1939 DEPT SURVEY FROM FD REMAINS OF U.S. BT'S, WHICH WERE STILL IN PLACE IN 1955 & SE STP REMAINS STILL VISIBLE AT TIME OF THIS SURVEY.	FD 5" FLANG ON SHAFT IN CONC BASE FOR SE COR SEC 13 AS SET BY M.SCHAAF FROM U.S. B.T.'S IN 1940 DEPT SURVEY. CORNER ALSO FD AND ACCEPTED IN 1955 DEPT SURVEY. COR IS IN SAND ROAD INTERSECTION N-S-E.	ESTABLISHED CTR OF THE SE1/4 OF SEC 13 PER STANDARD BLM INSTRUCTIONS. CTR OF TRAIL RD, NW-SE, IS 41'± N AND 52'± EAST.	ESTABLISHED NE COR OF SE1/4 OF SEC 13 PER STANDARD BLM INSTRUCTIONS. SW'LY EDGE OF CEDAR SWAMP IS 120'± 8' SOUTH (U.S. TIE WOULD BE 260' SOUTH).

C. Description of monument for corner and accessories established to perpetuate locating the position of the corner:

L-7	M-7	13	14
FD CONS DEPT MON AND SET CARSONITE MARKER POST. 3" MAPLE IN CLP N65°W 14.0' 4" MAPLE N40°E 22.5' 3" W.PINE S80°E 25.8' 7" R.PINE S10°E 28.3' 4" W.PINE S60°W 29.7'	FD 5" FLANG ON SHAFT IN 6"x 6" CONC BLK, RAISED W/1"x 15" PIPE W/PS CAP. SET CEDAR POST WITH LOC TAG WEST 16' #10" J.PINE N85°W 21.63' #14" R.OAK N35°W 55.63' # 9" R.OAK N25°E 72.53' 3" W.PINE N45°E 74.14' # = WIT BY OTHERS.	DROVE 5/8"x 34" REROD W/PS CAP & SET CEDAR POST W/LOC TAG. 11" W.OAK N10°E 20.6' 12" TW.OAK EAST 22.8' 12" OAK S10°E 35.6' 9" W.OAK S25°W 30.7'	DROVE 1"x 72" PIPE W/PS CAP AND SET CEDAR POST W/LOC TAG. 6" CEDAR N60°W 7.3' 6" CEDAR NORTH 8.0' 11" W.PINE N80°E 18.4' 7" CEDAR S50°E 4.1'

Signed by Carl T Kiiskila Date 2-2-95
 Surveyor's Michigan License No. 33981