91

LAND CORNER RECORDATION CERTIFICATE

Filing Requirement of Act 74, Mich. P.A. 1970

For corners in KALKASKA (County)

	Located In:	Corner Code ~~##~~
1. Public Land Survey	T 25N R 6W	K-5, K-6,
	T ___ R ___	L-5
	T ___ R ___	
	T ___ R ___	
2. Property Controlling	S 13 T ___ R ___	3
in Section	S ___ T ___ R ___	
3. Miscellaneous	S ___ T ___ R ___	
Property in Sec.	S ___ T ___ R ___	

Register of Deeds Stamp & File Number

4. Lot No. _____ , Recorded Plat _____
5. Private Claims _____

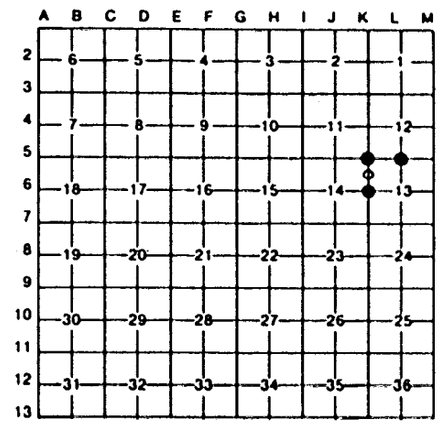

I, C.T.KIISKILA, in a field survey on FEB 2, 19 95, do hereby certify that under requirements of P.A. 74, Michigan P.A. of 1970, the corner points mentioned in lines 1 and 2 above were in conformance with regulations and rules therefore as required in the current manual of survey instructions of the United States Department of the Interior, Bureau of Land Management or by a decree of a Court of Law and/or that the corner points mentioned in lines 3, 4 and 5 above were in conformance with the rules of the Michigan Board of Land Surveyors or by a Decree of a Court of Law; established, re-established, monumented, re-monumented, recovered, found as expressed below:

NOTE: Not more than 4 corners, all in the same town and range, may be recorded on this certificate.

A. Description of original monument and accessories and/or subsequent restoration:

K-5 K-6 L-5 3

(NO EVIDENCE OF G.L.O. CORNER, B.T'S, LINE TREES & TOPOGRAPHY, AS CALLED OUT IN THE G.L.O. LINE NOTES; UNLESS NOTED IN ITEM "B" BELOW.)

STATE OF MICHIGAN
CARL KIISKILA
LAND SURVEYOR
No. 33981
LICENSED LAND SURVEYOR

B. Description of corner evidence found and/or method applied in restoring or reestablishing corner:

K-5
FOUND CONSERVATION DEPT MON AS SET IN 1955 DEPT SURVEY AT POSITION OF FD M.SCHAAF MON (AS SET IN 1939 DEPT SURVEY FROM FD U.S. B.T'S). CTR OF TRAIL RD, NE-SW, IS 310'± NORTH.

K-6
FD CONS. DEPT MON FOR W1/4 COR OF SEC 13 AS SET IN 1955 DEPT SURVEY AT POSITION OF FD M.SCHAAF MON. SCHAAF SET MON IN 1939 FROM U.S. B.T.(WHICH WAS STILL IN PLACE IN 1955 DEPT SURVEY). ONE STRAND OF SMOOTH WIRE FENCE RUNS N & E. CTR OF E-W TRAIL RD IS 518'± SOUTH.

L-5
FD CONSERVATION DEPT MON AS SET IN 1955 DEPT SURVEY IN PLACE OF FD M.SCHAAF MON. SCHAAF FD REMAINS OF U.S. GLO WIT SW AND DEFINITE J.PINE SITE NE IN 1939. SAND DIRT RD NW-SE IS N45°E 84'±. SINGLE STRAND OF B.WIRE ON CEDAR POSTS TO S AND WEST.

3
ESTABLISHED THE SW COR OF NW1/4 OF NW1/4 OF S-13 PER STANDARD BLM INSTRUCTIONS. COR OF SINGLE STRAND SMOOTH WIRE, RUNNING E & S, IS 34'± W AND 86'± N.

C. Description of monument for corner and accessories established to perpetuate locating the position of the corner:

K-5
FD CONSERVATION DEPT BRASS CAP ON 1" GALV. PIPE, SET CED POST.

9" J.PINE	N80°W	12.55'
12" J.PINE	N15°E	13.19'
‡10" J.PINE	S43°E	34.65'
‡14" J.PINE	S35°W	35.78'

K-6
FD CONS. DEPT MON, ADDED CEDAR POST.

‡12" J.PINE	N22°W	16.4'
7" R.PINE	N15°E	28.1'
3" W.PINE	S35°E	42.5'
10" R.PINE	WEST	3.0'

L-5
FD DNR MON & SET CEDAR POST.

‡26"R.PINE	N16°W	34.6'
‡26"R.PINE	N35°E	50.2'
7"R.PINE	S50°E	17.9'
5"R.PINE	S35°W	47.1'

3
DROVE 5/8"x 34" REROD W/PS CAP & SET CEDAR POST W/LOC TAG.

19" MAPLE	N65°W	38.9'
7" MAPLE	N40°E	27.3'
18" W.PINE	S15°E	16.4'
14" W.PINE	S70°W	18.3'

‡= RLS K.OSTLING 1955 WIT. ‡= RLS K.OSTLING 1955 WIT. ‡= RLS K.OSTLING 1955 WIT.

Signed by Carl T. Kiiskila Date 2-2-95

Surveyor's Michigan License No. 33981

FORM APPROVED BY MICHIGAN STATE BOARD OF LAND SURVEYORS, JAN. 28, 1971
REVISED MAY 14, 1975
REVISED JAN., 1983