

LAND CORNER RECORDATION CERTIFICATE

Filing Requirement of Act 74, Mich. PA 1970

For Corners In: <u>Kalkaska</u> (County)	Located In T <u>25N</u> R <u>6W</u> E <u>5</u> T _____ R _____ E _____	Corner Code # _____ _____ _____
2. Property Controlling in Section	S _____ T _____ R _____ S _____ T _____ R _____	_____ _____
3. Miscellaneous Property in Section	S _____ T _____ R _____ S _____ T _____ R _____	_____ _____


4. Lot No: _____ Recorded Plat: _____

5. Private Claims: _____

I, Craig W. McVean, in a field survey on January 31, 2000, do hereby state that under requirements of PA 74, Michigan PA of 1970, the corner points mentioned in lines 1 and 2 above were in conformance with regulations and rules therefore as required in the current manual of survey instructions of the United States Department of the Interior, Bureau of Land Management or by a decree of a Court of Law and/or that the corner points mentioned in lines 3, 4 and 5 above were in conformance with the rules of the Michigan Board of Land Surveyors or by a Decree of a Court of Law; established, re-established, monumented, recovered, found as expressed below:

NOTE: Not more than 2 corners, all in the same town and range, may be recorded on this certificate.

Register of Deeds Stamp & File Number

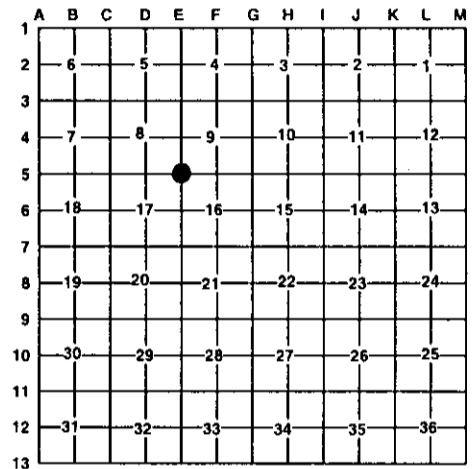

A. Description of original monument and accessories and/or subsequent restoration:

- | | |
|---|--|
| <p><u>E5</u> - GLO - set post - G.H. Cannon - 1852
 Sp. Pine 12" S22°E 36 L. - Dead
 Sp. Pine 9" N33°W 42 L. - Dead
 - Fargo Eng. - 1912 - No US evidence
 Set 1" iron pipe & crockery by proportion,
 Sp. Pine 8" N89°1/2E 39 1/2 L.
 Sp. Pine 10" N21°W 78 L.
 - M. Schaaf - 1941 - Fd. definite SE BT site.
 Checked East and at 9.20 Road N-S;
 9.37 (9.35-GLO) Cannon Cr. and an Old Bridge;</p> | <p>10.44 (10.43-GLO) intersect 16" Tam. Stp. of line tree on ground.
 Gr. J. Pine 14" S35°E 37.5 L., J. Pine 16" N8.5°E 56 L., J. Pine 4" N82°W37 L., J. Pine 4" S54.5°W 31 L., Con. Power corner is S16°W 33 L.
 - K.J. Ostling - set 1" pipe w/ 4" brass cap at M. Schaaf position.
 6" J. Pine N45°W 34.5 L., 7" J. Pine S55°W 31 L.
 - LCRC L.2, P.140 - W.P. Richards - 1978 - DNR Mon. Fd. - 8" J. Pine N25°E 8.87', 10" J. Pine N73°W 29.75', 8" J. Pine S58°W 20.49'
 - LCRC L.2, P.227 - C.F. Roser - Fd. DNR Mon. and add cedar post. 10" J. Pine N28°E 8.91' 9" J. Pine S59°W 20.48', 10" J. Pine N73°W 29.82', N-S Trail Rd. E 40±, winding trail S 22'± Rd. W'ly.</p> |
|---|--|

B. Description of corner evidence found and/or method applies in restoring or re-establishing corner:

- E5- Sec. Cor. Common to Sec. 8, 9, 16 & 17 - Fd. 4" DOC (DNR) brass cap on 1" iron pipe at M. Schaaf position by Ostling & used by Richards & Roser. Could find no evidence of Fargo's position S16°W 33 L. as it falls in graded road. CL of gravel road 24'± S. and CL. of Gravel Rd. N'ly is 24'± E. DOC (DNR) Mon. accepted as a careful and faithful perpetuation of the position of the original corner.

C. Description of monument for corner and accessories established to perpetuate locating the position of the corner:

- E5 - 4" Dept. of Cons. (DNR) brass cap on 1" iron pipe
 SE 0.6' to face fd. cedar post
 Set Blue Carsonite Post 1' W
 N22°E 8.76' to set N & T in E side 12" J. Pine (CFR, WPR)
 N3°E 32.72' to set N & T in W side 5" W. Pine
 N72°W 31.85' to set N & T in W side 3" W. Pine
 N47°W 22.73' to set N & T in NE side 9" J. Pine (KJO, MS)
 S50°W 20.46' to set N & T in NW side 11" J. Pine (KJO, MS, CFR)



Signed by: Craig W. McVean
 Surveyor's Michigan License No.: 39088

Date: 12/12/2003