

LAND CORNER RECORDATION CERTIFICATE

Filing Requirement of Act 74, Mich. PA 1970

For Corners In: Kalkaska (County)	Located In	Corner Code #
1. Public Land Survey	T <u>25N</u> R <u>6W</u>	<u>B9</u>
	T _____ R _____	_____
2. Property Controlling in Section	S _____ T _____ R _____	_____
	S _____ T _____ R _____	_____
3. Miscellaneous Property in Section	S _____ T _____ R _____	_____
	S _____ T _____ R _____	_____

4. Lot No: _____ Recorded Plat: _____

5. Private Claims: _____

I, Craig W. McVean, in a field survey on March 23, 2004 do hereby state that under requirements of PA 74, Michigan PA of 1970, the corner points mentioned in lines 1 and 2 above were in conformance with regulations and rules therefore as required in the current manual of survey instructions of the United States Department of the Interior, Bureau of Land Management or by a decree of a Court of Law and/or that the corner points mentioned in lines 3, 4 and 5 above were in conformance with the rules of the Michigan Board of Land Surveyors or by a Decree of a Court of Law; established, re-established, monumented, recovered, found as expressed below:

NOTE: Not more than 2 corners, all in the same town and range, may be recorded on this certificate.

Register of Deeds Stamp & File Number

	A	B	C	D	E	F	G	H	I	J	K	L	M
1													
2	6		5		4		3		2		1		
3													
4	7		8		9		10		11		12		
5													
6	18		17		16		15		14		13		
7													
8	19		20		21		22		23		24		
9	●												
10	30		29		28		27		26		25		
11													
12	31		32		33		34		35		36		
13													

A. Description of original monument and accessories and/or subsequent restoration:


- B9 – GLO – Set ¼ Post – G. H. Cannon – 1852
 - Sp. Pine 8" N26°E 27 L.
 - Sp. Pine 7" S45°W 7 L.
- Fargo Eng. – 1912 – Fd. Stake and both U.S. Wit.
One down, both coor. to U.S. Notes.
Set iron and crockery Mon. - W. Pine 18" S20°W 51¾
- M. Schaaf – 1941 – Fd. C.P. Co. iron at post. NE BT entire but down and w/good faces – at least 12" diameter.
SW BT Stp. in place. Both exact. YPS 12" S83°W 5:
Y. Pine Stp. stub 16" S18½°W 52; Y. Pine Stp. 24" S54½°E 1.25; WPS 18" N61°W 68
- DNR Cor. Rec. – D. C. De La Mater - 1955 – Fd. corner per Schaaf – OBT's still evident. Set 1" pipe w/ 4" Brass Cap - 4" Cherry N88°W 77 L.; 18" Y. Pine Stub S18°W 52 L.

B. Description of corner evidence found and/or method applied in restoring or re-establishing corner:

- B9 – ¼ Cor. Common to Sec. 19 & 30, T25N, R6W – Fd. 4" DOC Brass Cap on 1" iron pipe w/ ¾" x 2.5' long Fargo pipe w/ hooked end alongside – both leaning. Dug down and found some crockery. Fd. remains of Fargo BT; 4 Schaaf BT's and two De La Mater's BT's in agreement w/ monument. Removed Fargo pipe and plumbed DOC (DNR) Mon. for point. DOC (DNR) accepted as a careful and faithful perpetuation of the position of the original corner.

C. Description of monument for corner and accessories established to perpetuate locating the position of the corner:

- B9 – 4" DOC (DNR) Brass Cap on 1" iron pipe. Add mound of sand around Mon.
Fd. Blue Carsonite Post 1.45' SW
N40°W 29.13' to set N & T in NE side 10" Cherry
S64°W 50.16' to set N & T in SE side 11" R. Pine
S13°E 57.82' to set N & T in W side Tri. 14" R. Maple
S60°E 57.62' to set N & T in NE side 10" R. Pine
All BT's above were fd. blazed w/ small nails – Set N & T alongside.
West 3.95' to set spike and tag in centerline top of 12" YPS (MS)

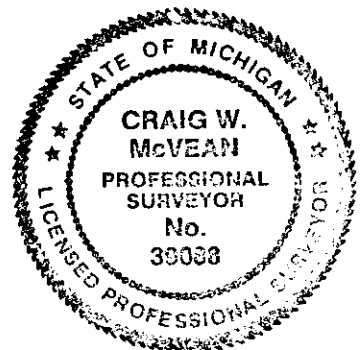

Signed by: Craig W. McVean
Surveyor's Michigan License No.: 39088

Date: 8/3/2004