

**LAND CORNER RECORDATION CERTIFICATE**  
**Filing Requirement of Act 74, Mich. P.A. 1970**

SURVEY &  
 RECORDATION

MAR 11 2000

For corners in

KALKASKA Located In: Corner Code #  
 (County)  
 1999 REMONUMENTATION  
 1. Public Land Survey T 25N R 7W B-9  
 T     R      
 T     R      
 T     R      
 2. Property Controlling S     T     R      
 in Section S     T     R      
 3. Miscellaneous S     T     R      
 Property in Sec. S     T     R    

SECTION



**3020150**  
 Page: 1 of 1  
 02/04/2000 03:40P  
 REMON  
 LB: B PG: 96

Register of Deeds Stamp & File Number

4. Lot No. \_\_\_\_\_, Recorded Plat \_\_\_\_\_  
 5. Private Claims \_\_\_\_\_

	A	B	C	D	E	F	G	H	I	J	K	L	M
1													
2	6	5	4	3	2	1							
3													
4	7	8	9	10	11	12							
5													
6	18	17	16	15	14	13							
7													
8	19	20	21	22	23	24							
9	●												
10	30	29	28	27	26	25							
11													
12	31	32	33	34	35	36							
13													


I, EUGENE FARRIER, in a field survey on November 9, 1999 do hereby state that under requirements of P.A. 74, Michigan P.A. of 1970, the corner points mentioned in lines 1 and 2 above were in conformance with regulations and rules therefore as required in the current manual of survey instructions of the United States Department of the Interior, Bureau of Land Management or by a decree of a Court of Law and for that the corner points mentioned in lines 3, 4 and 5 above were in conformance with the rules of the Michigan Board of Land Surveyors or by a Decree of a Court of Law; established, re-established, monumented, recovered, found as expressed below:

**NOTE:** Not more than 2 corners, all in the same town and range, may be recorded on this certificate.

A. Description of original monument and accessories and/or subsequent restoration:  
B-9: 1/4 Cor. Common to Sec. 19 & 30, T25N-R7W, Garfield Township  
 1853, G.L.O. Resurvey, by V.W. Caukin (Deputy Surveyor), County Survey Notes Pg 66, set 1/4 Section post, Hemlock 15", N42.5°E, 9 Lks; Hemlock 36", S28.5°E, 19 Lks  
 1907, Survey, by W.S. Merrill (Co. Surveyor) Co. Survey Bk 23, Pgs 48-50, found stone corner, no accessories  
 1912, Fargo Survey, found stone, accepted. Set iron crockery monument, Basswood 10", S73°E, 1.25, no other timber near

B. Description of corner evidence found and/or method applied in restoring or reestablishing corner:  
B-9: 1/4 Cor. Common to Sec. 19 & 30, T25N-R7W, Garfield Township  
 Set 5/8" X 12" rerod w/brass cap in mon. box, 1' East of fence to North and in centerline of road. Set by single proration to Merrill Survey. (There is enough cut in the road, I would not expect to find Fargo's iron or the stone)  
 North, 38.34', corner fence post, set nail & washer  
 N45°E, 76.20', fence post, set nail  
 S58°E, 80.94', fence post, set nail  
 N55°W, 63.3', steel fence post (face), set nail  
 No G.L.O. witnesses were found.

Ratified by Peer Group  
 P.A. 345 - 1990 Kalkaska County  
 Chairman Eugene Farrier  
 Date 02-03-00

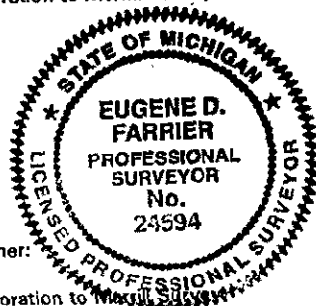

C. Description of monument for corner and accessories established to perpetuate locating the position of the corner:  
B-9: 1/4 Cor. Common to Sec. 19 & 30, T25N-R7W, Garfield Township  
 Set 5/8" X 12" rerod w/brass cap in mon. box, 1' East of fence to North and in centerline of road. Set by single proration to Merrill Survey.  
 North, 38.34', corner fence post, set nail & washer  
 N45°E, 76.20', fence post, set nail  
 S58°E, 80.94', fence post, set nail  
 N55°W, 63.3', steel fence post (face), set nail  
 Kalkaska County Peer Group accepted the above monument as a careful and faithful reestablishment of the position of the original corner.

Signed by Eugene Farrier  
 Michigan License No. 24594

Date 02-04-00 Surveyor's