

LAND CORNER RECORDATION CERTIFICATE
Filing Requirement of Act 74, Mich. P.A. 1970

For corners in

KALKASKA Located In: Corner Code #
(County)
 1998 REMONUMENTATION
 1. Public Land Survey T 25N R 7W C-2
 T ___ R ___
 T ___ R ___
 T ___ R ___
 2. Property Controlling S ___ T ___ R ___
 in Section S ___ T ___ R ___
 3. Miscellaneous S ___ T ___ R ___
 Property in Sec. S ___ T ___ R ___

**SURVEY &
 REMONUMENTATION**

FEB 22 1999

SECTION

Register of Deeds Stamp & File Number

4. Lot No. _____, Recorded Plat _____

5. Private Claims _____

1	A	B	C	D	E	F	G	H	I	J	K	L	I
2		6	•	5		4		3		2		1	
3													
4		7		8		9		10		11		12	
5													
6		18		17		16		15		14		13	
7													
8		19		20		21		22		23		24	
9													
10		30		29		28		27		26		25	
11													
12		31		32		33		34		35		36	
13													

I, EUGENE FARRIER, in a field survey on October 26, 1998 do hereby state that under requirements of P.A. 74, Michigan P.A. of 1970, the corner points mentioned in lines 1 and 2 above were in conformance with regulations and rules therefore as required in the current manual of survey instructions of the United States Department of the Interior, Bureau of Land Management or by a decree of a Court of Law and for that the corner points mentioned in lines 3, 4 and 5 above were in conformance with the rules of the Michigan Board of Land Surveyors or by a Decree of a Court of Law; established, re-established, monumented, recovered, found as expressed below:

NOTE: Not more than 2 corners, all in the same town and range, may be recorded on this certificate.

A. Description of original monument and accessories and/or subsequent restoration:

C-2: 1/4 Cor. Common to Secs. 5 & 6, T25N-R7W, Garfield Township
 1853, Subd. of Twp., by Deputy Surveyor T. Whelpley; set post; fd. Beech 3", N 29 1/4 W, 14 Lk. (9.24'); Birch 5", S 45 1/2 E, 8 Lk. (5.28')
 1903; 1908; 1910, Sec. sub. survey by W.S. Merrill, C.S., Co. Survey Bk., Pg 26, 45, & 57; FB #41, Pg 88 found corner; Maple 30" S 53°W, 29 Lks. (17.16'); Beech 10", West, 32 Lks., (21.12')
 9-28-79, B. Jones, found large spike, LCRC in Liber 2, Pg. 190
 9-3-85, N. DeYoung, found 1/2" rod, Liber 3, Pg. 3, Cert. of Survey
 9-4-87, N. DeYoung, found 1/2" rod, Liber 3, Pg. 3, Cert. of Survey
 8-14-88, N. DeYoung, found 1/2" rod, Liber 2, Pg. 842


B. Description of corner evidence found and/or method applied in restoring or reestablishing corner:

C-2: 1/4 Cor. Common to Secs. 5 & 6, T25N-R7W, Garfield Township
 Found and accepted 12" spike in CL North-South road on fence to West (as recorded in LCRC and previous Cert. of Surveys) Pulled and set 5/8" X 18" re-bar w/brass cap.
 No G.L.O. witnesses were found.
 Kalkaska County Peer Group accepted the above monument as the best available evidence of the position of the original corner.

Ratified by Peer Group
P.A. 345 - 1990 Kalkaska County
 Chairman Eugene Farrier
 Date 2-2-99

C. Description of monument for corner and accessories established to perpetuate locating the position of the corner:

C-2: 1/4 Cor. Common to Secs. 5 & 6, T25N-R7W, Garfield Township
 Found and accepted 12" spike in CL North-South road on fence to West. Pulled and set 5/8" X 18" re-bar w/brass cap.
 S28°E, 36.33' - 12" Twin Maple, set nail & washer
 N50°E, 30.86' - 10" Maple, set nail & washer
 N40°W, 69.58 - 10" R. Pine, set nail & washer
 S63°W, 45.92' - 16" R. Pine, set nail & washer

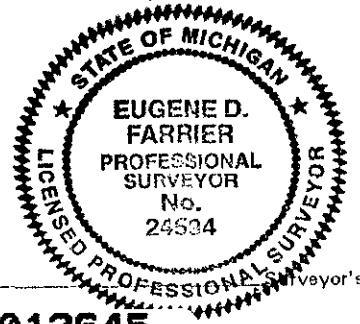

Signed by Eugene Farrier
 Michigan License No. 24594

Date 2-8-99 Surveyor's



3012645
 Page: 1 of 1
 02/10/1999 08:27A
 LB: 5 PG: 300

REVISORS, JAN. 28, 197
 REVISED MAY 14, 1971
 REVISED JAN., 1983
 REVISED OCT., 199