

LAND CORNER RECORDATION CERTIFICATE
Filing Requirement of Act 74, Mich. P.A. 1970

For corners in

KALKASKA Located In: _____ Corner Code # _____
 (County)
 1998 REMONUMENTATION
 1. Public Land Survey T 25N R 7W C-3
 T _____ R _____
 T _____ R _____
 T _____ R _____
 2. Property Controlling S _____ T _____ R _____
 in Section S _____ T _____ R _____
 3. Miscellaneous S _____ T _____ R _____
 Property in Sec. S _____ T _____ R _____


**SURVEY &
 REMONUMENTATION**

FEB 22 1999

SECTION

Register of Deeds Stamp & File Number

4. Lot No. _____, Recorded Plat _____
 5. Private Claims _____

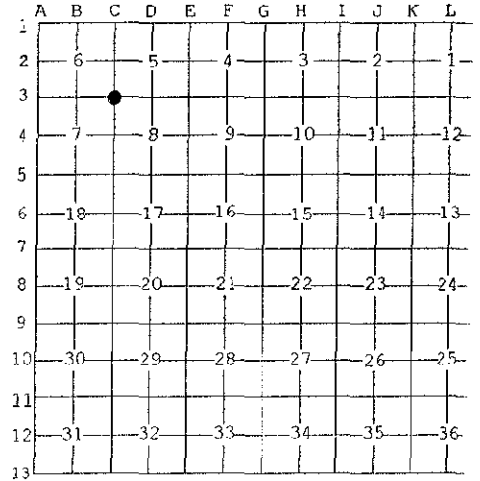

I, EUGENE FARRIER, in a field survey on October 30, 1998 do hereby state that under requirements of P.A. 74, Michigan P.A. of 1970, the corner points mentioned in lines 1 and 2 above were in conformance with regulations and rules therefore as required in the current manual of survey instructions of the United States Department of the Interior, Bureau of Land Management or by a decree of a Court of Law and /or that the corner points mentioned in lines 3, 4 and 5 above were in conformance with the rules of the Michigan Board of Land Surveyors or by a Decree of a Court of Law; established, re-established, monumented, recovered, found as expressed below:

NOTE: Not more than 2 corners, all in the same town and range, may be recorded on this certificate.

A. Description of original monument and accessories and/or subsequent restoration:

C-3: Sec. Cor. Common to Secs. 5, 6, 7, & 8, T25N-R7W, Garfield Township
 1853, Subd. of Twp., by Deputy Surveyor T. Whelpley; set post; Beech 8", S 51 1/2 W, 28 Lk. (18.48'); Beech 8", S 46° E, 23 Lk. (15.18'); Beech 5" N 35 1/2 W, 36 Lk. (23.76')
 1900, Sec. Sub. survey by W.S. Merrill, C.S., Co. Survey Bk., Pg 28, Found old corner stone & stake, set new stake and plow point
 1903, 1908, Sec. Sub. Survey by W.S. Merrill, C.S., Co. Survey Bk., Pg 26 & 45, found stake & iron buried
 1908, 1910, Sec. Sub. Survey by W.S. Merrill, C.S., Co. Survey Bk., Pg 45, FB # 41, Pg 88, found corner
 9-28-79, B. Jones, found 1/2" re-rod, LCRC in Liber 2, Pg. 190
 5-1-84, E. Farrier, found plow point, added 1/2" iron & cap #24594, Cert. of Survey
 9-4-87, N. DeYoung, found 1/2" rod, Cert of Survey
 11-26-97, D. Grier, found iron & cap in CL North-South road, Cert. of Survey
 7-9-98, R. Kral, found iron & cap #24594 in CL North-South road & 7' North of East-West road, Cert. of Survey

Ratified by Peer Group
 P.A. 345 - 1990 Kalkaska County
 Chairman Eugene Farrier
 Date 2-2-99

B. Description of corner evidence found and/or method applied in restoring or reestablishing corner:


C-3: Sec. Cor. Common to Secs. 5, 6, 7, & 8, T25N-R7W, Garfield Township
 Found and accepted 1/2" iron & cap #24594 in CL North-South rd & 7' North of East-West road (as recorded in LCRC and previous Cert. of Survey) Pulled and set 5/8" X 18" re-bar w/brass cap.
 N62°W, 69.70' - 30" Maple, found spike
 N22°E, 73.60' - 14" W. Pine, found spike
 S45°E, 53.73' - 20" W. Pine, found spike
 No G.L.O. witnesses were found.
 Kalkaska County Peer Group accepted the above monument as a careful and faithful perpetuation of the position of the original corner.

C. Description of monument for corner and accessories established to perpetuate locating the position of the corner:

C-3: Sec. Cor. Common to Secs. 5, 6, 7, & 8, T25N-R7W, Garfield Township
 Found and accepted 1/2" iron & cap #24594 in CL North-South rd & 7' North of East-West road. Pulled and set 5/8" X 18" re-bar w/brass cap.
 N62°W, 69.70' - 30" Maple, found spike
 N22°E, 73.60' - 14" W. Pine, found spike
 S45°E, 53.73' - 20" W. Pine, found spike
 S48°W, 75.12' - 40" Maple, set nail & washer

Signed by Eugene Farrier
 Michigan License No. 24594

Date 2-2-99

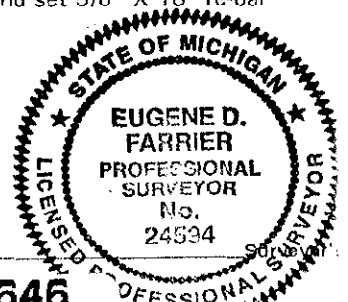

3012646
 Page: 1 of 1
 02/10/1999 08:28A
 LB: 5 PG: 301

REVISIONS: JAN. 28, 197
 REVISED MAY 14, 197
 REVISED JAN., 199
 REVISED OCT., 199