

LAND CORNER RECORDATION CERTIFICATE
Filing Requirement of Act 74, Mich. P.A. 1970

For corners in

<u>KALKASKA</u>	Located In:	Corner Code #
(County)		
1998 REMONUMENTATION		
1. Public Land Survey	T. <u>25N</u> R. <u>7W</u>	<u>C-5</u>
	T. _____ R. _____	_____
	T. _____ R. _____	_____
	T. _____ R. _____	_____
2. Property Controlling in Section	S. _____ T. _____ R. _____	_____
	S. _____ T. _____ R. _____	_____
3. Miscellaneous Property in Sec.	S. _____ T. _____ R. _____	_____
	S. _____ T. _____ R. _____	_____

**SURVEY &
REMONUMENTATION**

FEB 22 1999

SECTION

Register of Deeds Stamp & File Number

4. Lot No. _____, Recorded Plat _____

5. Private Claims _____

I, EUGENE FARRIER, in a field survey on October 28, 1998 do hereby state that under requirements of P.A. 74, Michigan P.A. of 1970, the corner points mentioned in lines 1 and 2 above were in conformance with regulations and rules therefore as required in the current manual of survey instructions of the United States Department of the Interior, Bureau of Land Management or by a decree of a Court of Law and /or that the corner points mentioned in lines 3, 4 and 5 above were in conformance with the rules of the Michigan Board of Land Surveyors or by a Decree of a Court of Law; established, re-established, monumented, recovered, found as expressed below:

A	B	C	D	E	F	G	H	I	J	K	L	M
1												
2	5		5		4		3		2		1	
3												
4	7		8		9		10		11		12	
5		●										
6	18		17		16		15		14		13	
7												
8	19		20		21		22		23		24	
9												
10	30		29		28		27		26		25	
11												
12	31		32		33		34		35		36	
13												

NOTE: Not more than 2 corners, all in the same town and range, may be recorded on this certificate.

A. Description of original monument and accessories and/or subsequent restoration:

C-5: Sec. Cor. Common to Secs. 7, 8, 17, & 18, T25N-R7W, Garfield Township
 1853, Subd. of Twp, by Deputy Surveyor T. Whelpley; set Beech 5" post; Sugar 12" N 68 1/2°E, 10 Lk. (6.60'); Beech 6", S 13°E, 37 Lk. (29.42'); Sugar 20", N 73 1/2°W, 20 Lk. (13.20')
 1899, Sec. Sub. Survey by J.A. Campbell, C.S., Co. Survey Bk., Pg 2, found corner
 1900, Sec. Sub. Survey by W.S. Merrill, C.S., Co. Survey Bk., Pg 28, found old corner stone
 1908, 1914, Sec. Sub. Survey by W.S. Merrill, C.S., Co. Survey Bk., Pg 45 & FB #34, Pg 87; found corner
 7-28-71, J. Wilcox, found 1 1/4" iron pipe in CL road int. raised w/8" boat spike LCRC in Liber 1, Pg. 9


B. Description of corner evidence found and/or method applied in restoring or reestablishing corner:

C-5: Sec. Cor. Common to Secs. 7, 8, 17, & 18, T25N-R7W, Garfield Township
 Found and accepted P.K. over boat spike, over 1 1/4" iron pipe in CL 4-way road int. (as recorded in LCRC Liber 1, Pg. 9) Pulled P.K. and boat spike, then added 5/8" X 18" re-bar w/brass cap in mon. box
 S45°W, 54.68' - Power pole, found nail
 N40°W, 44.30' - Face Stop sign post, found nail
 No G.L.O. witnesses were found.
 Kalkaska County Peer Group accepted the above monument as the best available evidence of the position of the original corner.

Ratified by Peer Group
 P.A. 345 - 1990 Kalkaska County
 Chairman Eugene Farrier
 Date 2-2-99

C. Description of monument for corner and accessories established to perpetuate locating the position of the corner:

C-5: Sec. Cor. Common to Secs. 7, 8, 17, & 18, T25N-R7W, Garfield Township
 Found and accepted P.K. over boat spike, over 1 1/4" iron pipe in CL 4-way road int. Pulled P.K. and boat spike, then added 5/8" X 18" re-bar w/brass cap in mon. box
 N63°E, 74.75' - Power pole, set nail & washer
 S37°E, 44.12' - Face Stop sign post, set nail & washer
 S45°W, 54.68' - Power pole, found nail
 N40°W, 44.30' - Face Stop sign post, found nail

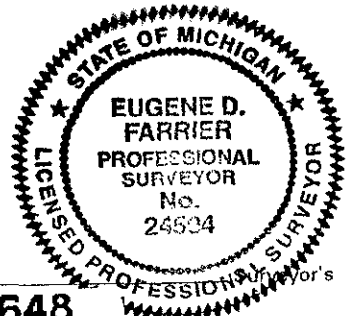

Signed by Eugene Farrier
 Michigan License No. 24594

Date 2-8-99

3012648
 Page: 1 of 1
 02/10/1999 08:28A



NAL SURVEYORS, JAN. 28, 1971
 REVISED MAY 14, 1975
 REVISED JAN., 1983
 REVISED OCT., 1995