

LAND CORNER RECORDATION CERTIFICATE
 Filing Requirement of Act 74, Mich. P.A. 1970

RECORDED & INDEXED
 MAR 01 2000

MAR 01 2000

SECTION

For corners in

KALKASKA Located In: Corner Code #
 (County)
 1999 REMONUMENTATION
 1. Public Land Survey T 25N R 7W D-7
 T _____ R _____
 T _____ R _____
 T _____ R _____
 2. Property Controlling S _____ T _____ R _____
 in Section S _____ T _____ R _____
 3. Miscellaneous S _____ T _____ R _____
 Property in Sec. S _____ T _____ R _____



3020155
 Page: 1 of 1
 02/04/2000 03:40P
 REMON
 LB: 6 PG: 101

4. Lot No. _____, Recorded Plat _____
 5. Private Claims _____

	A	B	C	D	E	F	G	H	I	J	K	L	M
1													
2		6		5		4		3		2		1	
3													
4		7		8		9		10		11		12	
5													
6		10		17		16		15		14		13	
7													
8		19		20		21		22		23		24	
9													
10		30		29		28		27		26		25	
11													
12		31		32		33		34		35		36	
13													


I, EUGENE FARRIER, in a field survey on November 2, 1999 do hereby state that under requirements of P.A. 74, Michigan P.A. of 1970, the corner points mentioned in lines 1 and 2 above were in conformance with regulations and rules therefore as required in the current manual of survey instructions of the United States Department of the Interior, Bureau of Land Management or by a decree of a Court of Law and for that the corner points mentioned in lines 3, 4 and 5 above were in conformance with the rules of the Michigan Board of Land Surveyors or by a Decree of a Court of Law; established, re-established, monumented, recovered, found as expressed below:

NOTE: Not more than 2 corners, all in the same town and range, may be recorded on this certificate.

A. Description of original monument and accessories and/or subsequent restoration:
D-7: 1/4 Cor. Common to Sec. 17 & 20, T25N-R7W, Garfield Township
 1852, G.L.O. Resurvey, by V.W. Caukin (Deputy Surveyor) Co. Survey Notes Pg. 20, set post, Sugar 14", S28.75°W, 11 Lks (7.26'); Sugar 10", N2.5°W, 20 Lks (13.2')
 1914, Survey, by W.S. Merrill (Co. Surveyor) Co. Survey Bk 34, Pgs 87 & 88, Cedar stake proportional distance, no accessories
 1980, LCRC, by J.L. Fletcher, recorded in Liber 2, Pg. 199 & 200, found hooked 3/4" iron rod, nail in Twin 4" P. Cherry N52°E, 74.10'; nail in Twin 6" Poplar, N01°E, 35.94'; nail in Twin 22" Cherry, N59°W, 26.85'
 1982, LCRC & Survey, by E. Farrier (Co. Surveyor), (LCRC recorded in Liber 2, Pg. 309), found "X" in 5/8" anchor iron, N50°W, 26.88', 28" Cherry; North 33.00', 1/2" rod & RLS cap #19830; N70°E, 69.30', 6" Cherry; N55°E, 74.15', 7" Cherry
 1985, Survey, by N.DeYoung, recorded in Liber 3, Pg. 237, no accessories
 1993, Survey, by E. Farrier (Co. Surveyor), same witnesses as Farrier (1982)

B. Description of corner evidence found and/or method applied in restoring or reestablishing corner:
D-7: 1/4 Cor. Common to Sec. 17 & 20, T25N-R7W, Garfield Township
 Found and accepted 5/8" hook iron in centerline of E-W road and 75' West of centerline of road South extended.
 N63°W, 26.62', 30" Cherry, set nail & washer
 North 33.05', iron & cap #19830
 N80°E, 105.23', power pole, set nail & washer
 S07°E, 50.69', 12" Cherry, set nail & washer over old nail
 No G.L.O. witnesses were found.

Ratified by Peer Group
 P.A. 345 - 1990 Kalkaska County
 Chairman [Signature]
 Date 02-03-00

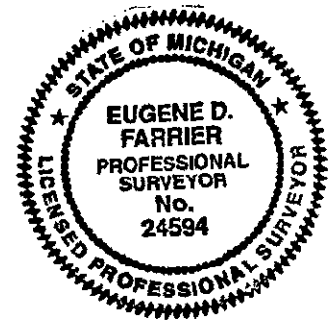

C. Description of monument for corner and accessories established to perpetuate locating the position of the corner:
D-7: 1/4 Cor. Common to Sec. 17 & 20, T25N-R7W, Garfield Township
 Found and accepted 5/8" hook iron in centerline of E-W road and 75' West of centerline of road South extended. Added 5/8" X 18" rerod w/ brass cap.
 N63°W, 26.62', 30" Cherry, set nail & washer
 North 33.05', iron & cap #19830
 N80°E, 105.23', power pole, set nail & washer
 S07°E, 50.69', 12" Cherry, set nail & washer over old nail
 Kalkaska County Peer Group accepted the above monument as a careful and faithful reestablishment of the position of the original corner.

Signed by [Signature]
 Michigan License No. 24594

Date 02-04-00 Surveyor's