

LAND CORNER RECORDATION CERTIFICATE
Filing Requirement of Act 74, Mich. P.A. 1970

SURVEY &
 SECTION
 MAY 11 2000

For corners in

KALKASKA Located In: _____ Corner Code # _____
 (County)

1999 REMONUMENTATION

- | | | |
|------------------------------------|----------------------------|------------|
| 1. Public Land Survey | T. <u>25N</u> R. <u>7W</u> | <u>D-9</u> |
| | T. _____ R. _____ | _____ |
| | T. _____ R. _____ | _____ |
| | T. _____ R. _____ | _____ |
| 2. Property Controlling in Section | S. _____ T. _____ R. _____ | _____ |
| | S. _____ T. _____ R. _____ | _____ |
| 3. Miscellaneous Property in Sec. | S. _____ T. _____ R. _____ | _____ |
| | S. _____ T. _____ R. _____ | _____ |

SECTION


3020156
 Page: 1 of 1
 02/04/2000 03:40P
 REMON
 LB: 6 PG: 102
 Kalkaska County Joan Hall, Register

4. Lot No. _____, Recorded Plat _____

5. Private Claims _____

I, EUGENE FARRIER, in a field survey on November 9, 1999 do hereby state that under requirements of P.A. 74, Michigan P.A. of 1970, the corner points mentioned in lines 1 and 2 above were in conformance with regulations and rules therefore as required in the current manual of survey instructions of the United States Department of the Interior, Bureau of Land Management or by a decree of a Court of Law and /or that the corner points mentioned in lines 3, 4 and 5 above were in conformance with the rules of the Michigan Board of Land Surveyors or by a Decree of a Court of Law; established, re-established, monumented, recovered, found as expressed below:

NOTE: Not more than 2 corners, all in the same town and range, may be recorded on this certificate.

1	A	B	C	D	E	F	G	H	I	J	K	L	M
2		6		5		4		3		2		1	
3													
4		7		8		9		10		11		12	
5													
6		18		17		16		15		14		13	
7													
8		19		20		21		22		23		24	
9													
10		30		29		28		27		26		25	
11													
12		31		32		33		34		35		36	
13													


A. Description of original monument and accessories and/or subsequent restoration:

D-9: 1/4 Cor. Common to Sec. 20 & 29, T25N-R7W, Garfield Township
 1853, G.L.O. Resurvey, by V.W. Caukin (Deputy Surveyor) Co. Survey Notes Pg 65, set 1/4 Section post, Beech 14", S42.25°E, 35 Lks; Birch 14", N35.75°E, 10 Lks.
 1912, Survey, Fargo, found stone Mr. Lund says perpetuates US corner in centerline of road, E, W N & S accepted; Black Cherry 10", N50°E, 2.42 Ch; Black Cherry 7", S84.25°W, 1.71 1/2 Ch
 1973, LCRC, by J.F. Erickson, recorded in Liber 1, Pg 199, found 1" pipe in monument box on centerline of Lund Road & N-S road; N45°W, phone pole, 53.26'; S40°E, 30" Elm, 50.82'
 1985; 1993; 1995, Survey, by E. Farrier (Co. Surveyor), found 1" iron pipe in mon. box, same wit as Erickson (1973)

B. Description of corner evidence found and/or method applied in restoring or reestablishing corner:

D-9: 1/4 Cor. Common to Sec. 20 & 29, T25N-R7W, Garfield Township
 Found 1" iron pipe in mon. box in centerline of 3-way road intersection.
 N47°W, 53.24', power pole, found nail & tag
 S22°E, 70.11', service pole, set nail & washer
 S20°W, 45.18', face sign post
 N38°E, 54.70', 3" Cherry, set nail & washer
 No G.L.O. witnesses were found.

Ratified by Peer Group
 P.A. 345 - 1990 Kalkaska County
 Chairman Eugene Farrier
 Date 02-03-00

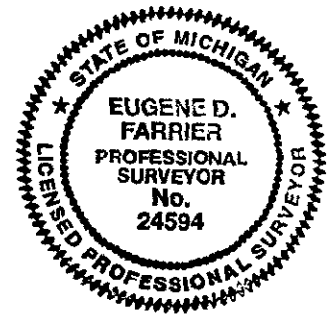

C. Description of monument for corner and accessories established to perpetuate locating the position of the corner:

D-9: 1/4 Cor. Common to Sec. 20 & 29, T25N-R7W, Garfield Township
 Found 1" iron pipe in mon. box in centerline of 3-way road intersection. Added 5/8" X 18" rerod w/brass cap.
 N47°W, 53.24', power pole, found nail & tag
 S22°E, 70.11', service pole, set nail & washer
 S20°W, 45.18', face sign post
 N38°E, 54.70', 3" Cherry, set nail & washer
 Kalkaska County Peer Group accepted the above monument as the best available evidence of the position of the original corner.

Signed by Eugene Farrier
 Michigan License No. 24594

Date 02-04-00 Surveyor's