

LAND CORNER RECORDATION CERTIFICATE  
Filing Requirement of Act 74, Mich. P.A. 1970

SURVEY &  
REMONUMENTATION

For corners in

KALKASKA Located In: \_\_\_\_\_ Corner Code # \_\_\_\_\_  
(County)  
1998 REMONUMENTATION  
1. Public Land Survey T 25N R 7W E-2  
T \_\_\_\_\_ R \_\_\_\_\_  
T \_\_\_\_\_ R \_\_\_\_\_  
T \_\_\_\_\_ R \_\_\_\_\_  
2. Property Controlling S \_\_\_\_\_ T \_\_\_\_\_ R \_\_\_\_\_  
in Section S \_\_\_\_\_ T \_\_\_\_\_ R \_\_\_\_\_  
3. Miscellaneous S \_\_\_\_\_ T \_\_\_\_\_ R \_\_\_\_\_  
Property in Sec. S \_\_\_\_\_ T \_\_\_\_\_ R \_\_\_\_\_

FEB 22 1999


SECTION

Register of Deeds Stamp & File Number

4. Lot No. \_\_\_\_\_, Recorded Plat \_\_\_\_\_  
5. Private Claims \_\_\_\_\_

I, EUGENE FARRIER, in a field survey on October 28, 1998 do hereby state that under requirements of P.A. 74, Michigan P.A. of 1970, the corner points mentioned in lines 1 and 2 above were in conformance with regulations and rules therefore as required in the current manual of survey instructions of the United States Department of the Interior, Bureau of Land Management or by a decree of a Court of Law and for that the corner points mentioned in lines 3, 4 and 5 above were in conformance with the rules of the Michigan Board of Land Surveyors or by a Decree of a Court of Law; established, re-established, monumented, recovered, found as expressed below:

NOTE: Not more than 2 corners, all in the same town and range, may be recorded on this certificate.

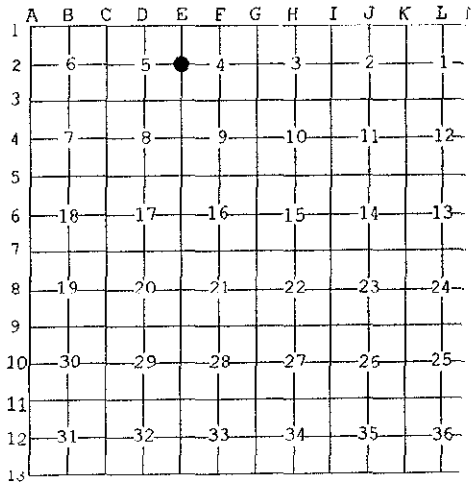

A. Description of original monument and accessories and/or subsequent restoration:

E-2: 1/4 Cor. Common to Secs. 4 & 5, T25N-R7W, Garfield Township  
1853, Subd. of Twp., by Deputy Surveyor T. Whelpley; set post; beech 7", N 8° E, 34 Lk. (22.44');  
Beech 8", N 78 W, 21 Lk. (13.86')  
1903, Sec. Sub. Survey by W.S. Merrill, C.S., Co. Survey Bk., Pg 29; set iron stake at pro-dist; Beech,  
S 32° W, 45 Lks. (29.70)  
1908, Sec. Sub. Survey by W.S. Merrill, C.S., Co. Survey Bk., Pg 45; shows finding corner  
1910, Sec. Sub. Survey by W.S. Merrill, C.S., FB # 41, Pg 88; fd cor; Hemlock 8", S11°E, 15 Lks. (9.90'); Beech 10", N26°W, 21 Lks  
(13.86').  
1958, Road Survey by W.R. Downey, R.L.S. with M.S.H.D.; fd steel fence post N 10° E, 58.43', 12" Elm; S 63° W, 54.81', 23 " Elm;  
55° E, 43.57', 28" Elm; Also shows finding 1" bar, S 64° E, 78.22', 12" Apple; N 88°E, 95.00', 5" Maple; N 69° E, 104.24'  
8" Elm  
9-28-79, B. Jones, found 5/8" iron in mon. box, LCRC Liber 2, Pg. 190  
5-24-90, E. Farrier, found bolt spike in mon. box 1' West of CL M-66, LCRC, Liber 2, Pg. 417

B. Description of corner evidence found and/or method applied in restoring or reestablishing corner:

E-2: 1/4 Cor. Common to Secs. 4 & 5, T25N-R7W, Garfield Township  
Found and accepted bolt spike 0.5' West of CL M-66 in mon. box on fence to West (as recorded in LCRCs) Pulled and set 5/8" X 18" re bar w/brass cap.  
No G.L.O. witnesses were found.  
Kalkaska County Peer Group accepted the above monument as the best available evidence of the position of the original corner.


Ratified by Peer Group  
P.A. 345 - 1990 Kalkaska County  
Chairman Eugene D. Farrier  
Date 2-2-99

C. Description of monument for corner and accessories established to perpetuate locating the position of the corner:

E-2: 1/4 Cor. Common to Secs. 4 & 5, T25N-R7W, Garfield Township  
Found and accepted bolt spike 0.5' West of CL M-66 in mon. box on fence to West; Pulled and set 5/8" X 18" re-bar w/brass cap.  
N70°E, 27.92' - Wood guard rail post, set nail & washer  
S35°E, 42.12' - Wood guard rail post, set nail & washer  
S37°W, 38.45' - Wood guard rail post, set nail & washer  
West, 22.82' - Wood guard rail post, set nail & washer

Signed by Eugene D. Farrier  
Michigan License No. 24594

Date 2-2-99

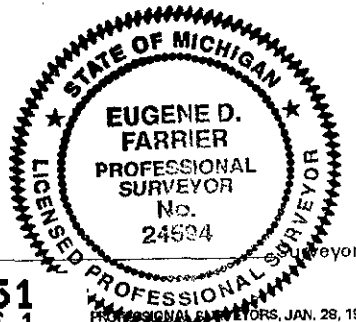

Kalkaska County REMON 9.00 LB: 5 PG: 305

3012651  
Page: 1 of 1  
02/10/1999 08:29A

PROFESSIONAL SURVEYORS, JAN. 28, 19'  
REVISED MAY 14, 19'  
REVISED JAN. 19'  
REVISED OCT. 19'