

LAND CORNER RECORDATION CERTIFICATE
Filing Requirement of Act 74, Mich. P.A. 1970

CLERK &
 MAR 12 2000
 SECTION

For corners in

KALKASKA
 (County)

Located In:

Corner Code #

1999 REMONUMENTATION

1. Public Land Survey

T.25N R.7W

F-5

T R

T R

T R

2. Property Controlling
 in Section

S T R

S T R

3. Miscellaneous
 Property in Sec.

S T R

S T R



3020163
 Page: 1 of 1
 02/04/2000 03:40P
 REMON
 LB: 8 PG: 109

4. Lot No. _____, Recorded Plat _____

5. Private Claims _____

	A	B	C	D	E	F	G	H	I	J	K	L	M
1													
2	6		5		4		3		2		1		
3													
4	7		8		9		10		11		12		
5													
6	18		17		16		15		14		13		
7													
8	19		20		21		22		23		24		
9													
10	30		29		28		27		26		25		
11													
12	31		32		33		34		35		36		
13													

I, EUGENE FARRIER, in a field survey on November 4, 1999 do hereby state that under requirements of P.A. 74, Michigan P.A. of 1970, the corner points mentioned in lines 1 and 2 above were in conformance with regulations and rules therefore as required in the current manual of survey instructions of the United States Department of the Interior, Bureau of Land Management or by a decree of a Court of Law and for that the corner points mentioned in lines 3, 4 and 5 above were in conformance with the rules of the Michigan Board of Land Surveyors or by a Decree of a Court of Law; established, re-established, monumented, recovered, found as expressed below:

NOTE: Not more than 2 corners, all in the same town and range, may be recorded on this certificate.

A. Description of original monument and accessories and/or subsequent restoration:

F-5: 1/4 Cor. Common to Sec. 9 & 16, T25N-R7W, Garfield Township

1853, G.L.O. Resurvey, by V.W. Caukin (Deputy Surveyor), Co. Survey Notes Pg 49, set 1/4 sec. post, Hemlock 12", N19°E, 16 Lks; Beech 8", S64°E, 33 Lks

1905, Survey, by W.S. Merrill (Co. Surveyor) Co. Survey Bk 22, Pg. 44-46, found iron stake, no accessories

1975, Survey, by J.L. Fletcher, recorded in Liber 1, Pg. 722-723 & 757-758, found 1" rod, 18" Elm, S15°E, 36.01'; 12" Apple, S78°E, 94.56'; 6" R. Pine, 15°, 45.28'

1989, LCRC & Survey, by E. Farrier, found 1" iron pipe, centerline E-W road North, 4'; nail in 12" Apple S48°E, 68.12'; nail in 10" R. Pine, N16°W, 45.25'; nail in 5" Apple, N45°E, 43.98'; nail in 10" R. Pine, S09°W, 103.79'

1998, Survey, by Farrier Surveying, found same as Farrier (1989)

B. Description of corner evidence found and/or method applied in restoring or reestablishing corner:

F-5: 1/4 Cor. Common to Sec. 9 & 16, T25N-R7W, Garfield Township

Found 1" solid bar in centerline E-W road.

N16°W, 45.25', 12" R. Pine, set nail & washer

N27°E, 48.27', 10" R. Pine, set nail & washer

S48°E, 68.12', 12" Apple, found nail


S09°W, 103.79', 12" R. Pine, found nail

No G.L.O. witnesses were found.

Ratified by Peer Group
 P.A. 345 - 1990 Kalkaska County

Chairman Eugene Farrier

Date 02-03-00

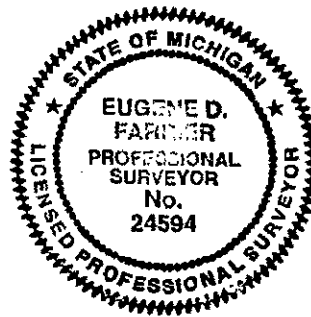

C. Description of monument for corner and accessories established to perpetuate locating the position of the corner:

F-5: 1/4 Cor. Common to Sec. 9 & 16, T25N-R7W, Garfield Township

Found 1" solid bar in centerline E-W road. Added 5/8" X 18" rerod w/brass cap.

N16°W, 45.25', 12" R. Pine, set nail & washer

N27°E, 48.27', 10" R. Pine, set nail & washer

S48°E, 68.12', 12" Apple, found nail

S09°W, 103.79', 12" R. Pine, found nail

Kalkaska County Peer Group accepted the best available evidence of the position of the original corner.

Signed by Eugene Farrier
 Michigan License No. 24594

Date 02-04-00 Surveyor's