

LAND CORNER RECORDATION CERTIFICATE
Filing Requirement of Act 74, Mich. P.A. 1970

SWEET &
 REYNOLDS

MAR 01 2000

For corners in

KALKASKA
 (County)

Located In:

Corner Code #

1999 REMONUMENTATION
 1. Public Land Survey

T 25N R 7W F-9

T _____ R _____

T _____ R _____

T _____ R _____

2. Property Controlling
 in Section

S _____ T _____ R _____

S _____ T _____ R _____

3. Miscellaneous
 Property in Sec.

S _____ T _____ R _____

S _____ T _____ R _____

SECTION

3020165

Page: 1 of 1
 02/04/2000 03:40P
 REMON
 LB: 8 PG: 111



4. Lot No. _____, Recorded Plat _____

5. Private Claims _____

I, EUGENE FARRIER, in a field survey on November 2, 1999 do hereby state that under requirements of P.A. 74, Michigan P.A. of 1970, the corner points mentioned in lines 1 and 2 above were in conformance with regulations and rules therefore as required in the current manual of survey instructions of the United States Department of the Interior, Bureau of Land Management or by a decree of a Court of Law and /or that the corner points mentioned in lines 3, 4 and 5 above were in conformance with the rules of the Michigan Board of Land Surveyors or by a Decree of a Court of Law; established, re-established, monumented, recovered, found as expressed below:

NOTE: Not more than 2 corners, all in the same town and range, may be recorded on this certificate.

| | A | B | C | D | E | F | G | H | I | J | K | L | M |
|----|---|----|---|----|---|----|---|----|---|----|---|----|---|
| 1 | | | | | | | | | | | | | |
| 2 | | 6 | | 5 | | 4 | | 3 | | 2 | | 1 | |
| 3 | | | | | | | | | | | | | |
| 4 | | 7 | | 8 | | 9 | | 10 | | 11 | | 12 | |
| 5 | | | | | | | | | | | | | |
| 6 | | 18 | | 17 | | 16 | | 15 | | 14 | | 13 | |
| 7 | | | | | | | | | | | | | |
| 8 | | 19 | | 20 | | 21 | | 22 | | 23 | | 24 | |
| 9 | | | | | | | | | | | | | |
| 10 | | 30 | | 29 | | 28 | | 27 | | 26 | | 25 | |
| 11 | | | | | | | | | | | | | |
| 12 | | 31 | | 32 | | 33 | | 34 | | 35 | | 36 | |
| 13 | | | | | | | | | | | | | |


A. Description of original monument and accessories and/or subsequent restoration:

F-9: 1/4 Cor. Common to Sec. 21 & 28, T25N-R7W, Garfield Township
 1853, G.L.O. Resurvey, by V.W. Caukin (Deputy Surveyor) Co. Survey Notes Pgs. 59 & 60, set post, Hemlock 10", N29.5°E, 25 Lks (16.5'); Hemlock 14", S37.5°E, 4 Lks (2.64')
 1912, Fargo survey, no U.S. evidence found, set 3/4" iron pipe prorated, W. Pine stump, 24", N54°E, 0.43 Ch. (31.68'); W. Pine stump 30", S55°W, 1.20 Ch. (79.2')
 1974, LCRC & Survey, by J.L. Wilcox, (LCRC recorded in Liber 1, Pg. 341; Survey recorded in Liber 1, Pg. 615), found 3/4" pipe, S25°E, 38.83'; S85°W, 43.02', 10" Oak; N25°E, 29.45', 5" Maple
 1977 & 1978, Survey, by N.F. Parker, (1977- recorded in Liber 2, Pg. 17; 1978- recorded in Liber 2, Pg. 282), 7" Oak, S25°E, 38.83'; 10" Oak, S85°W, 43.02'; 5" Maple, N25°E, 29.45'
 1977, LCRC, by J.L. Wilcox, recorded in Liber 2, Pg. 26, same witnesses as Wilcox (1974)
 1980, 1987, & 1992 Survey, by E. Farrier, same witnesses as Parker (1978)

B. Description of corner evidence found and/or method applied in restoring or reestablishing corner:

F-9: 1/4 Cor. Common to Sec. 21 & 28, T25N-R7W, Garfield Township
 Found 3/4" pinched pipe in centerline E-W 2 track 42' +/- South of o.h.p.
 N15°W, 13.39', 3" Oak, set nail & washer
 N33°E, 29.45', 10" Oak, set nail & washer
 S55°E, 16.43', 3" J. Pine, set nail & washer
 S28°W, 36.92', 16" Twin Oak, set nail & washer
 No G.L.O. witnesses were found.

Ratified by Peer Group
P.A. 345 - 1990 Kalkaska County
 Chairman [Signature]
 Date 02-03-00

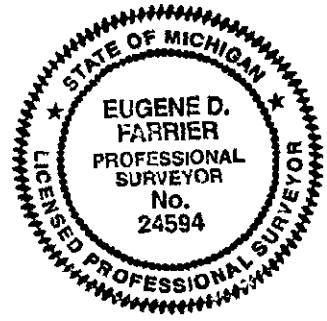

C. Description of monument for corner and accessories established to perpetuate locating the position of the corner:

F-9: 1/4 Cor. Common to Sec. 21 & 28, T25N-R7W, Garfield Township
 Found 3/4" pinched pipe in centerline E-W 2 track 42' +/- South of o.h.p. Pulled & set 5/8" X 36" rerod w/aluminum cap.
 N15°W, 13.39', 3" Oak, set nail & washer
 N33°E, 29.45', 10" Oak, set nail & washer
 S55°E, 16.43', 3" J. Pine, set nail & washer
 S28°W, 36.92', 16" Twin Oak, set nail & washer
 Kalkaska County Peer Group accepted the above monument as a careful and faithful reestablishment of the position of the original corner.

Signed by [Signature]
 Michigan License No. 24594

Date 02-04-00 Surveyor's