

LAND CORNER RECORDATION CERTIFICATE
Filing Requirement of Act 74, Mich. P.A. 1970

For corners in

KALKASKA Located In: _____ Corner Code # _____
 (County)
 1999 REMONUMENTATION
 1. Public Land Survey T 25N R 7W _____ G-3
 T _____ R _____
 T _____ R _____
 T _____ R _____
 2. Property Controlling S _____ T _____ R _____
 in Section S _____ T _____ R _____
 3. Miscellaneous S _____ T _____ R _____
 Property in Sec. S _____ T _____ R _____

SUTHERBY &
 REGISTERED PROFESSIONAL SURVEYORS

MAR 11 2000


SECTION _____



3020168
 Page: 1 of 1
 02/04/2000 03:40P
 REMON
 LB: 6 PG: 114

4. Lot No. _____, Recorded Plat _____
 5. Private Claims _____

I, EUGENE FARRIER, in a field survey on November 5, 1999 do hereby state that under requirements of P.A. 74, Michigan P.A. of 1970, the corner points mentioned in lines 1 and 2 above were in conformance with regulations and rules therefore as required in the current manual of survey instructions of the United States Department of the Interior, Bureau of Land Management or by a decree of a Court of Law and /or that the corner points mentioned in lines 3, 4 and 5 above were in conformance with the rules of the Michigan Board of Land Surveyors or by a Decree of a Court of Law; established, re-established, monumented, recovered, found as expressed below:

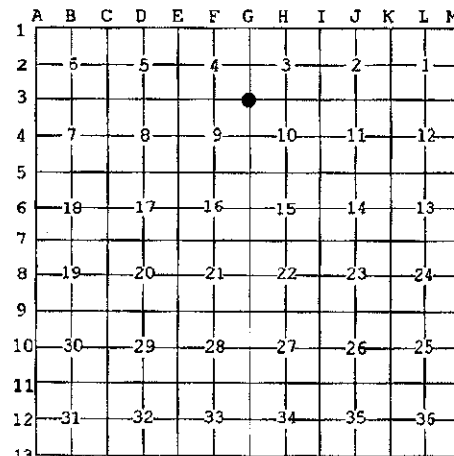


NOTE: Not more than 2 corners, all in the same town and range, may be recorded on this certificate.

A. Description of original monument and accessories and/or subsequent restoration:
G-3: Sec. Cor. Common to Sec. 3, 4, 9, & 10, T25N-R7W, Garfield Township
 1853, G.L.O. Resurvey, by V.W. Caukin (Deputy Surveyor) Co. Survey Notes Pg 44, set post corner, Beach 6", S46.25°E, 16 Lks; Beach 8", N54°E, 47 Lks; Beach 5", S78.25°W, 33 Lks
 1900 & 1904, Survey, by W.S. Merrill (Co. Surveyor) Co. Survey Bk 11, Pgs 84 & 85, visited corner, no accessories
 1903, Survey, W.S. Merrill (Co. Surveyor) Co. Survey Bk 25, Pgs 2 & 3, stone corner, no accessories
 1986, Survey, by E. Farrier (Co. Surveyor) found 3/4" iron pipe in centerline of road intersection, N33°W, 52.05', power pole; S40°E, 45.5' street sign; S45°W, 48.06, tele. post; N33°E, 61.97', Twin 6" & 8" R. Pine
 1989, Survey & LCRC, by E. Farrier (Co. Surveyor), (Survey recorded in Liber 3, Pg. 312; LCRC recorded in Liber 2, Pg. 393), found 3/4" iron pipe
 1990, Survey, by E. Farrier (Co. Surveyor), found 3/4" iron pipe
 1992, Survey, by E. Farrier (Co. Surveyor), found 3/4" iron pipe
 1994, LCRC, by P. Stout, found 1" iron; 24" Elm, N74°W, 117.80'; 16" Box Elder, S44°E, 49.88'; 3/8" rod in 1" pipe, set mon box; N38°E, 62.02', 10" Twin Pine; N36°W, 52.14', power pole; S46°W, 46.32' power pole; S31°E, 42.03', West edge of traffic sign.
 1997, Survey, by R. Kral, found 3/4" iron pipe

B. Description of corner evidence found and/or method applied in restoring or reestablishing corner:
G-3: Sec. Cor. Common to Sec. 3, 4, 9, & 10, T25N-R7W, Garfield Township
 Found 3/4" iron pipe in mon. box in centerline 4-way road intersection.
 N33°E, 61.97', Twin 12" & 6" R. Pine, found nail
 S40°E, 45.5', stop sign post, found nail
 S45°W, 48.06', power pole, set nail & washer over old nail
 N33°W, 52.05, power pole
 No GLO witnesses were found.

Ratified by Peer Group
P.A. 345 - 1990 Kalkaska County
 Chairman Eugene Farrier
 Date 02-03-00

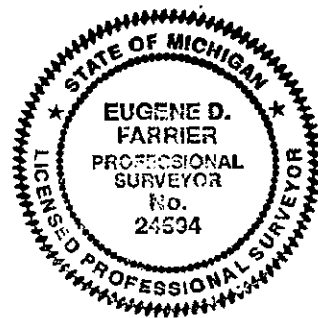

C. Description of monument for corner and accessories established to perpetuate locating the position of the corner:
G-3: Sec. Cor. Common to Sec. 3, 4, 9, & 10, T25N-R7W, Garfield Township
 Found 3/4" iron pipe in mon. box in centerline 4-way road intersection. Added 5/8" X 18" rerod w/brass cap.
 N33°E, 61.97', Twin 12" & 6" R. Pine, found nail
 S40°E, 45.5', stop sign post, found nail
 S45°W, 48.06', power pole, set nail & washer over old nail
 N33°W, 52.05, power pole
 Kalkaska County Peer Group accepted the above monument as the best available evidence of the position of the original corner.

Signed by Eugene Farrier Date 02-04-00 Surveyor's
 Michigan License No. 24594