

LAND CORNER RECORDATION CERTIFICATE
Filing Requirement of Act 74, Mich. P.A. 1970

For corners in

RECORDED
 MAR 11 2000
 SECTION

KALKASKA Located in: Corner Code #
 (County)
 1999 REMONUMENTATION
 1. Public Land Survey T 25N R 7W G-7
 T ___ R ___
 T ___ R ___
 T ___ R ___
 2. Property Controlling S ___ T ___ R ___
 in Section S ___ T ___ R ___
 3. Miscellaneous S ___ T ___ R ___
 Property in Sec. S ___ T ___ R ___

3020172
 Page: 1 of 1
 02/04/2000 03:40P
 REMON
 LB: 8 PG: 118

4. Lot No. _____, Recorded Plat _____

5. Private Claims _____

I, EUGENE FARRIER, in a field survey on November 2, 1999 do hereby state that under requirements of P.A. 74, Michigan P.A. of 1970, the corner points mentioned in lines 1 and 2 above were in conformance with regulations and rules therefore as required in the current manual of survey instructions of the United States Department of the Interior, Bureau of Land Management or by a decree of a Court of Law and/or that the corner points mentioned in lines 3, 4 and 5 above were in conformance with the rules of the Michigan Board of Land Surveyors or by a Decree of a Court of Law; established, re-established, monumented, recovered, found as expressed below:

	A	B	C	D	E	F	G	H	I	J	K	L	M		
1															
2		6		5			4			3		2		1	
3															
4		7					8			9		10		11	12
5															
6		18					17			16		15		14	13
7															
8		19					20			21		22		23	24
9															
10		30					29			28		27		26	25
11															
12		31					32			33		34		35	36
13															

NOTE: Not more than 2 corners, all in the same town and range, may be recorded on this certificate.


A. Description of original monument and accessories and/or subsequent restoration:

G-7; Sec. Cor. Common to Sec. 15, 16, 21, & 22, T25N-R7W, Garfield Township
 1853, G.L.O. Resurvey, by V.W. Caukin (Deputy Surveyor) Co. Survey Notes Pg. 21, set post, Sugar 24", S60°E, 24 Lks (15.84'); Beech 12", N39.25°E, 24 Lks (15.84'); Sugar 12", N50.5°W, 26 Lks (17.16')
 1905, Survey, W.S. Merrill (Co. Surveyor) Co. Survey Bk 22, Pg. 44-46, visited corner, no accessories
 1912, Fargo, found three U.S. witness, Sugar 8", N37°W, 0.72 Ch. (47.52'); Sugar 6", S71.5°W, 0.51 Ch. (33.66')
 1933, H.L. Botsford, found 3/4" pipe, 8" Elm, N16°E, 57.4'; 14" Elm stump N14°W, 70'; 8" Elm, N14°W, 159.3'
 1981, LCRC & Survey, E. Farrier (Co. Surveyor) (LCRC recorded in Liber 2, Pg. 304), set 1/2" rod & RLS cap # 24594 in West wheel track of trail & 12' South of fence East & 30' South of new fence and row of planted Red Pines. Used two 1933 witnesses that fit a survey South for one mile; S55°W, 50.50', 20" Maple, N15°W, 32.33', 1" Pipe (bad corner); N63°E, 30.12', 8" R. Pine; S88°E, 26.00'; 6" R. Pine; S50°E, 34.74', 7" R. Pine; S88°E, 33.00', 1/2" rod & RLS cap #24594
 1981, LCRC, by E. Farrier (Co. Surveyor), recorded in Liber 2, Pg. 305, found 3/4" iron pipe that fit 1933 survey made by Cons. Power, N06°E, 31.55', 2" Pipe (bad corner); N15°E, 82.75', power pole; East, 55.10', 20" Maple; S80°W, 22.22', 8" R. Pine, N34°W, 28.30', 7" Cherry
 1982, Consumers Power, D. Ankrom, found Fargo iron & crockery, 2 1/2" pipe, N2°E, 31.6'; 5" Red Pine, S85°W, 22.22'; 12" Maple, N75°E, 55.12'; 6" W. Cherry, N25°W, 28.33'
 1984, Survey, by E. Farrier (Co. Surveyor), found 1/2" Iron & Cap # 21265, set by D. Ankrom for Cons. Power Co. (1982)
 1988, Survey, by C.L. Robinson, recorded in Liber 3, Pg. 296, found 1/2" iron pipe; 2" iron pipe, N04°E, 30.82'; 15" Maple, N89°E, 55.18'; 9" R. Pine, N17°E, 59.98'; 6" R. Pine, S81°W, 22.24'

B. Description of corner evidence found and/or method applied in restoring or reestablishing corner:

G-7; Sec. Cor. Common to Sec. 15, 16, 21, & 22, T25N-R7W, Garfield Township
 Found and accepted 1/2" X 18" rerod 2' West of centerline of N-S seasonal road & 6' South of Red Pine plantation to East, 31' South of fence to West.
 N15°W, 32.33', 1" pipe unaccepted for corner
 N78°E, 26.48', 14" R. Pine, set nail & washer
 S67°E, 41.20', 14" R. Pine, set nail & washer
 S50°W, 50.56', 24" Maple, set nail & washer
 N25°W, 33.32', 14" R. Pine, set nail & washer
 No G.L.O. witnesses were found.

Ratified by Peer Group
 P.A. 345 - 1990 Kalkaska County
 Chairman Eugene Farrier
 Date 02-03-00

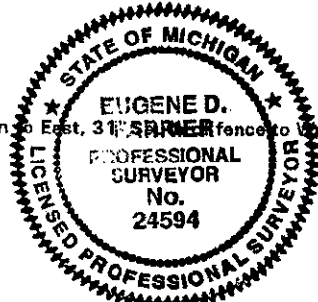

C. Description of monument for corner and accessories established to perpetuate locating the position of the corner:

G-7; Sec. Cor. Common to Sec. 15, 16, 21, & 22, T25N-R7W, Garfield Township
 Found and accepted 1/2" X 18" rerod 2' West of centerline of N-S seasonal road & 6' South of Red Pine plantation to East, 31' South of fence to West. Pulled & replaced with 5/8" X 18" rerod.
 N15°W, 32.33', 1" pipe unaccepted for corner
 N78°E, 26.48', 14" R. Pine, set nail & washer
 S67°E, 41.20', 14" R. Pine, set nail & washer
 S50°W, 50.56', 24" Maple, set nail & washer
 N25°W, 33.32', 14" R. Pine, set nail & washer
 Kalkaska County Peer Group accepted the above monument as a careful and faithful perpetuation of the position of the original corner.

Signed by Eugene Farrier Date 02-04-00 Surveyor's
 Michigan License No. 24594