

LAND CORNER RECORDATION CERTIFICATE
Filing Requirement of Act 74, Mich. P.A. 1970

CLERK &
 REGISTER
 MAR 01 2000

For corners in

KALKASKA
 (County)

Located In: Corner Code #

1999 REMONUMENTATION

1. Public Land Survey

T 25N R 7W G-8

SECTION

2. Property Controlling
 in Section

S T R
 S T R

3. Miscellaneous
 Property in Sec.

S T R
 S T R



3020173
 Page: 1 of 1
 02/04/2000 03:40P
 REMON
 LB: 8 PG: 119

Kalkaska County Joan Hall, Register

4. Lot No. _____, Recorded Plat _____

5. Private Claims _____

	A	B	C	D	E	F	G	H	I	J	K	L	M
1													
2		6		5		4		3		2		1	
3													
4		7		8		9		10		11		12	
5													
6		18		17		16		15		14		13	
7													
8		19		20		21		22		23		24	
9													
10		30		29		28		27		26		25	
11													
12		31		32		33		34		35		36	
13													

I, EUGENE FARRIER, in a field survey on November 2, 1999 do hereby state that under requirements of P.A. 74, Michigan P.A. of 1970, the corner points mentioned in lines 1 and 2 above were in conformance with regulations and rules therefore as required in the current manual of survey instructions of the United States Department of the Interior, Bureau of Land Management or by a decree of a Court of Law and for that the corner points mentioned in lines 3, 4 and 5 above were in conformance with the rules of the Michigan Board of Land Surveyors or by a Decree of a Court of Law; established, re-established, monumented, recovered, found as expressed below:

NOTE: Not more than 2 corners, all in the same town and range, may be recorded on this certificate.

A. Description of original monument and accessories and/or subsequent restoration:

G-8: 1/4 Cor. Common to Sec. 21 & 22, T25N-R7W, Garfield Township

1853, G.L.O. Resurvey, by V.W. Caukin (Deputy Surveyor) Co. Survey Notes Pg. 43, set post, Sugar 12", S59°E, 9 Lks (5.94'); Sugar 10", N24°W, 35 Lks (23.10')

1912, Fargo, no U.S. witnesses found, Black Cherry, 7", S34°W, 0.71 Ch (46.86'); Maple 16", N37.5°E, 0.89 Ch (58.74')

1933, H.L. Botsford, found no corner W 1/4 post, established 1/4 post found 6" Cherry stump, scribed S45°W, 33.8'; Marked 12" Lynn, N45°E, 50.2'

1978, LCRC N.F. Parker, recorded in Liber 2, Pg. 148, found 1" bar on East edge of trail, NBT 6" Maple, S45°E, 15.9'; NBT, 4" Maple, S47°W, 19.6';

NBT, 8" Maple, S82°W, 23.2'

1980, Consumers Power Co, found 1" solid bar

B. Description of corner evidence found and/or method applied in restoring or reestablishing corner:

G-8: 1/4 Cor. Common to Sec. 21 & 22, T25N-R7W, Garfield Township

Found and accepted 1" X 28" piece of axle shaft, 5' East of centerline N-S road.

N15°E, 9.42', 6" Maple, set nail & washer

S77°E, 2.03', 5" Twin Maple, set nail & washer

S43°W, 19.75', 6" Maple, set nail & washer


S80°W, 23.54', 10" Twin Maple, set nail & washer

No G.L.O. witnesses were found.

Ratified by Peer Group
P.A. 345 - 1990 Kalkaska County

Chairman Eugene Farrier

Date 02-03-00

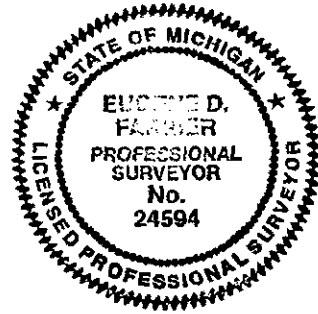

C. Description of monument for corner and accessories established to perpetuate locating the position of the corner:

G-8: 1/4 Cor. Common to Sec. 21 & 22, T25N-R7W, Garfield Township

Found and accepted 1" X 28" piece of axle shaft, 5' East of centerline N-S road. Pulled & replaced with 5/8" X 36" rerod w/brass cap.

N15°E, 9.42', 6" Maple, set nail & washer

S77°E, 2.03', 5" Twin Maple, set nail & washer

S43°W, 19.75', 6" Maple, set nail & washer

S80°W, 23.54', 10" Twin Maple, set nail & washer

Kalkaska County Peer Group accepted the above monument as a careful and faithful reestablishment of the position of the original corner.

Signed by Eugene Farrier
 Michigan License No. 24594

Date 02-04-00 Surveyor's