

LAND CORNER RECORDATION CERTIFICATE
Filing Requirement of Act 74, Mich. P.A. 1970

E. FARRIER &
 REGISTERED PROFESSIONAL SURVEYOR

MAR 01 2000

For corners in

KALKASKA Located In: _____ Corner Code # _____
 (County)
 1999 REMONUMENTATION
 1. Public Land Survey T 25N R 7W _____ 14 _____
 T _____ R _____
 T _____ R _____
 T _____ R _____
 2. Property Controlling S _____ T _____ R _____
 in Section S _____ T _____ R _____
 3. Miscellaneous S _____ T _____ R _____
 Property in Sec. S _____ T _____ R _____

SECTION _____



3020181
 Page: 1 of 1
 02/04/2000 03:40P
 REMON
 LB: 8 PG: 127

4. Lot No. _____, Recorded Plat _____
 5. Private Claims _____

	A	B	C	D	E	F	G	H	I	J	K	L	M
1													
2	6		5		4		3		2		1		
3													
4	7		8		9		10		11		12		
5													
6	18		17		16		15		14		13		
7													
8	19		20		21		22		23		24		
9													
10	30		29		28		27		26		25		
11													
12	31		32		33		34		35		36		
13													


I, EUGENE FARRIER, in a field survey on November 4, 1999, do hereby state that under requirements of P.A. 74, Michigan P.A. of 1970, the corner points mentioned in lines 1 and 2 above were in conformance with regulations and rules therefore as required in the current manual of survey instructions of the United States Department of the Interior, Bureau of Land Management or by a decree of a Court of Law and/or that the corner points mentioned in lines 3, 4 and 5 above were in conformance with the rules of the Michigan Board of Land Surveyors or by a Decree of a Court of Law; established, re-established, monumented, recovered, found as expressed below:

NOTE: Not more than 2 corners, all in the same town and range, may be recorded on this certificate.

A. Description of original monument and accessories and/or subsequent restoration:
1-4: 1/4 Cor. Common to Secs. 10 & 11, T25N-R7W, Garfield Twp
 1853, G.L.O. Resurvey, V.W. Caukin (Deputy Surveyor) Co. Survey Notes, Pg 37, set 1/4 sec. post, Beech 6" N60.75°W, 13 Lks; Beech 5", 27.5°E, 22 Lks
 1901, Survey, by W.S. Merrill (Co. Surveyor) Co. Survey Bk 11, Pg 84 & 85, visited corner, no accessories
 1904 & 1907, Survey, by W.S. Merrill (Co. Surveyor) Co. Survey Bk 25, Pg 132, Cedar stake & stones, Maple 34", N40°E, 36 Lks
 1912, Survey, by Fargo, found stone buried for corner by Co. Surveyor, no U.S. evidence found, found Sugar stub w/ hack 24", N47°E, 0.40 1/2
 1984, Survey, by E. Farrier (Co. Surveyor) set corner MPOL centerline of road & 1' North of E-W fences, N30°W, 52.54', 17" Maple; N88°E, 27.63', 20" Maple; S68°W, 31.00'; S24°W, 74.52', 12" Maple.
 1990, Survey & LCRC, by B. Jones, (Survey recorded in Liber 3, Pg. 363; LCRC recorded in Liber 3, Pg. 412), found 1/2" iron, N84°E, 30" Maple, 27.55'; S23°W, 18" Maple, 74.57'; N30°W, 20" Maple, 52.35'; S65°W, 12" Maple, 31.0'
 1992, Survey, by B. Jones, recorded in Liber 4, Pg. 118, same as 1990
 1999, Survey, by E. Farrier (Co. Surveyor), used same corner for survey in Section 11

B. Description of corner evidence found and/or method applied in restoring or reestablishing corner:
1-4: 1/4 Cor. Common to Secs. 10 & 11, T25N-R7W, Garfield Twp
 Found 1/2" X 18" iron & cap #24594 in centerline of N-S road on fence to East & West.
 East, 33.12', iron & cap #23514
 S35°E, 34.05', 5" Elm, set nail & washer
 S67°W, 31.00', 12" Maple, found nail
 N35°W, 52.41', 18" Maple, set nail & washer
 No G.L.O. witnesses were found.

Ratified by Peer Group
 P.A. 345 - 1990 Kalkaska County
 Chairman Eugene Farrier
 Date 02-03-00

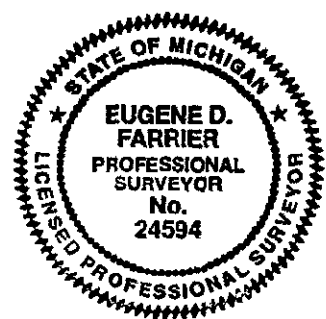

C. Description of monument for corner and accessories established to perpetuate locating the position of the corner:
1-4: 1/4 Cor. Common to Secs. 10 & 11, T25N-R7W, Garfield Twp
 Found 1/2" X 18" iron & cap #24594 in centerline of N-S road on fence to East & West. Pulled & replaced with 5/8" X 18" rod w/ brass cap.
 East, 33.12', iron & cap #23514
 S35°E, 34.05', 5" Elm, set nail & washer
 S67°W, 31.00', 12" Maple, found nail
 N35°W, 52.41', 18" Maple, set nail & washer
 Kalkaska County Peer Group accepted the above monument as a careful and faithful reestablishment of the position of the original corner.

Signed by Eugene Farrier
 Surveyor's Michigan License No. 24594

Date 02-04-00