

**LAND CORNER RECORDATION CERTIFICATE**  
**Filing Requirement of Act 74, Mich. P.A. 1970**

SURVEY &  
 RECORDS

For corners in

KALKASKA  
 (County)

Located In:

Corner Code #

MAP ( ) 2000

1999 REMONUMENTATION

1. Public Land Survey

T 25N R 7W I-5

T \_\_\_\_\_ R \_\_\_\_\_

T \_\_\_\_\_ R \_\_\_\_\_

T \_\_\_\_\_ R \_\_\_\_\_

2. Property Controlling  
 in Section

S \_\_\_\_\_ T \_\_\_\_\_ R \_\_\_\_\_

S \_\_\_\_\_ T \_\_\_\_\_ R \_\_\_\_\_

3. Miscellaneous  
 Property in Sec.

S \_\_\_\_\_ T \_\_\_\_\_ R \_\_\_\_\_

S \_\_\_\_\_ T \_\_\_\_\_ R \_\_\_\_\_

SECTION

**3020182**

Page: 1 of 1  
 02/04/2000 03:40P  
 REMON  
 LB: 6 PG: 128



4. Lot No. \_\_\_\_\_, Recorded Plat \_\_\_\_\_

5. Private Claims \_\_\_\_\_

	A	B	C	D	E	F	G	H	I	J	K	L	M
1													
2	6	5	4	3	2	1							
3													
4	7	8	9	10	11	12							
5													
6	18	17	16	15	14	13							
7													
8	19	20	21	22	23	24							
9													
10	30	29	28	27	26	25							
11													
12	31	32	33	34	35	36							
13													

I, EUGENE FARRIER, in a field survey on November 4, 1999 do hereby state that under requirements of P.A. 74, Michigan P.A. of 1970, the corner points mentioned in lines 1 and 2 above were in conformance with regulations and rules therefore as required in the current manual of survey instructions of the United States Department of the Interior, Bureau of Land Management or by a decree of a Court of Law and /or that the corner points mentioned in lines 3, 4 and 5 above were in conformance with the rules of the Michigan Board of Land Surveyors or by a Decree of a Court of Law; established, re-established, monumented, recovered, found as expressed below:

**NOTE: Not more than 2 corners, all in the same town and range, may be recorded on this certificate.**

A. Description of original monument and accessories and/or subsequent restoration:

I-5: Sec. Cor. Common to Secs. 10, 11, 14, & 15 T25N-R7W, Garfield Twp


- 1853, G.L.O. Resurvey, V.W. Caukin (Deputy Surveyor) Co. Survey Notes, Pg 37, set sec. corner post, Beech 10" S24.75°W, 33 Lks; Beech 4", S17°E, 28 Lks; Beech 12", N52.75°E, 40 Lks
- 1901 & 1903, Survey, by W.S. Merrill (Co. Surveyor) Co. Survey Bk 11, Pg 84 & 85 and Bk 25, Pgs. 20 & 21, 132 & 133, visited corner, no accessories
- 1904 & 1907, Survey, by W.S. Merrill (Co. Surveyor) Co. Survey Bk 25, Pg 132, Cedar stake & stones, (1904-Maple 30", S18°W, 41.5 Lks) (1907-Maple 34", N40°E, 38 Lks)
- 1912, Survey, by Fargo, found one U.S. witness & stake surrounded by stones, Beech 12" (now 16"), S23.5°W, 0.31 Ch.
- 1980, Consumers Power Co, found 3/4" Fargo pipe 6" below surface
- 1984, Survey, by E. Farrier (Co. Surveyor) found 3/4" pipe and used it to set I-4
- 1990, Survey & LCRC, by B. Jones, (Survey recorded in Liber 3, Pg. 363; LCRC recorded in Liber 3, Pg. 412) found 3/4" pipe, N12°W, 25" Maple, 69.85'; N75°W, 25" Maple, 48.61'; S53°W, fence post, 35.0'; N85°W, 15" Twin Maple, 40.73'
- 1992, Survey, by B. Jonas, survey recorded in Liber 4, Pg. 116, same as 1990.
- 1999, Survey, by E. Farrier (Co. Surveyor), used same corner for survey in Section 11

B. Description of corner evidence found and/or method applied in restoring or reestablishing corner:

I-5: Sec. Cor. Common to Secs. 10, 11, 14, & 15 T25N-R7W, Garfield Twp

Found 1" iron pipe 3' West of centerline of N-S road on fence to East & in centerline of 2-track to West. Also 24' North of fence to West & 24' South of fence to West.  
 East, 33.00', iron & cap #24594  
 S50°W, 35.08', corner fence post, found nail  
 N80°W, 48.64', 24" Maple, found nail  
 N17°W, 69.96', set nail & washer  
 No G.L.O. witnesses were found.

Ratified by Peer Group  
 P.A. 345 - 1990 Kalkaska County  
 Chairman Eugene Farrier  
 Date 02-03-00

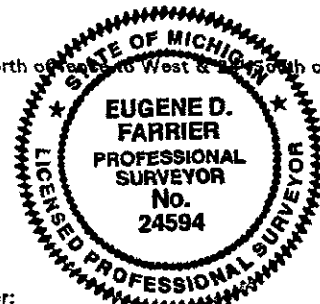

C. Description of monument for corner and accessories established to perpetuate locating the position of the corner:

I-5: Sec. Cor. Common to Secs. 10, 11, 14, & 15 T25N-R7W, Garfield Twp

Found 1" iron pipe 3' West of centerline of N-S road on fence to East & in centerline of 2-track to West. Also 24' North of fence to West & 24' South of fence to West. Added 5/8" X 18" rerod w/ brass cap.  
 East, 33.12', Iron & cap #23514  
 East, 33.00', iron & cap #24594  
 S50°W, 35.08', corner fence post, found nail  
 N80°W, 48.64', 24" Maple, found nail  
 N17°W, 69.95', 28" Maple, set nail & washer  
 Kalkaska County Peer Group accepted the above monument as a careful and faithful perpetuation of the position of the original corner.

Signed by Eugene Farrier  
 Surveyor's Michigan License No. 24594

Date 02-04-00