

LAND CORNER RECORDATION CERTIFICATE
Filing Requirement of Act 74, Mich. P.A. 1970

For corners in

Kalkaska Located In: _____ Corner Code # _____
 (County)

1. Public Land Survey T 25N R 7W K-2
 T _____ R _____

2. Property Controlling _____
 in Section S _____ T _____ R _____
 S _____ T _____ R _____

3. Miscellaneous _____
 Property in Sec. S _____ T _____ R _____

4. Lot No. _____, Recorded Plat _____

5. Private Claims _____

I, Craig W. McVean, in a field survey on Feb. 24, 19 98 do hereby state that under requirements of P.A. 74, Michigan P.A. of 1970, the corner points mentioned in lines 1 and 2 above were in conformance with regulations and rules therefore as required in the current manual of survey instructions of the United States Department of the Interior, Bureau of Land Management or by a decree of a Court of Law and /or that the corner points mentioned in lines 3, 4 and 5 above were in conformance with the rules of the Michigan Board of Land Surveyors or by a Decree of a Court of Law; established, re-established, monumented, recovered, found as expressed below.

NOTE: Not more than 2 corners, all in the same town and range, may be recorded on this certificate.

A. Description of original monument and accessories and/or subsequent restoration:

K-2 - GLO - Set 1/4 post. Tho. Whelpley - 1853
 Hemlock 30" N48 3/4°E 5 L.
 Hemlock 10" N62 3/4°W 29 L.
 - Fargo Eng. - B.L. Caulkin - 1912 - Fnd. stk. & 2 Hem. stp's. per U.S. - set iron & crockery mon.
 - Rec. Survey L.3 P. 102 - E. Farrier - 1987 - Fnd 1" pipe per Fargo in N-S fence line.
 N5°W 31.60' 7" Cedar
 S35°E 15.23' 6" Balsam
 N37°E 5.84' 8" Balsam
 N50°W 19.32' 10" Balsam

B. Description of corner evidence found and/or method applied in restoring or reestablishing corner:

K-2 - 1/4 Corner common to Sec. 1 & Sec. 2, T25N, R7W- Fnd. P.S. cap #24594 (EF) in 1" O.D. x 2.3" iron pipe with hook foot end per Fargo Eng. Also, fnd. 1" x 7" long cedar stake at base of pipe. No crockery found. Fargo pipe accepted as a careful and faithful perpetuation of the position of the original corner.

C. Description of monument for corner and accessories established to perpetuate locating the position of the corner:


K-2 - Replaced Fargo pipe w/ 4" DNR Alum. cap on 1" x 36" galv. iron pipe.- Reset stake on N. side at base pipe.
 * N7°W 31.70' to set N&T in E. Side 8" Cedar (EF)
 * N53°W 19.50' to set N&T in NE Side 11" B. Fir (EF)
 * S41°E 15.24' to set N&T in SE Side 8" B. Fir (EF)
 S8°W 74.78' to set N&T in E. Side 9" Cedar - scribed 'XBT'
 S56°W 70.88' to set N&T in NE Side 7" Cedar - scribed 'XBT'
 Set Blue Carsonite post 1' SE - Fnd. 4" Cedar post NE 0.85' to face.

* EDF wit nails above.

Ratified by Peer Group
 P.A. 345 - 1990 Kalkaska County
 Chairman [Signature]
 Date 12-14-99



Signed by Craig W. McVean Date 12/9/1999
 Surveyor's Michigan License No. 39088

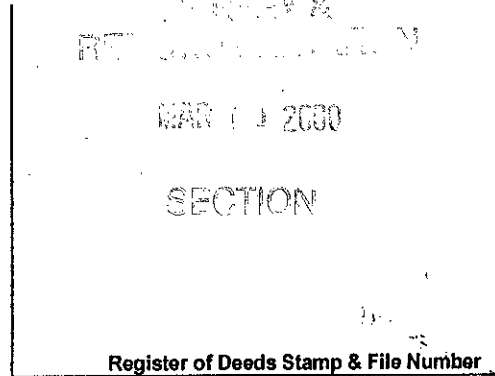

	A	B	C	D	E	F	G	H	I	J	K	L	M
1													
2	6		5		4		3		2		1		
3													
4	7		8		9		10		11		12		
5													
6	18		17		16		15		14		13		
7													
8	19		20		21		22		23		24		
9													
10	30		29		28		27		26		25		
11													
12	31		32		33		34		35		36		
13													

