


**LAND CORNER RECORDATION CERTIFICATE**  
**Filing Requirement of Act 74, Mich. P.A. 1970**

For corners in

<u>Kalkaska</u> (County)	Located In:	Corner Code #
1. Public Land Survey	T <u>25N</u> R <u>7W</u>	<u>K-4</u>
2. Property Controlling in Section	S _____ T _____ R _____	_____
3. Miscellaneous Property in Sec.	S _____ T _____ R _____	_____
4. Lot No. _____, Recorded Plat _____	S _____ T _____ R _____	_____
5. Private Claims _____		

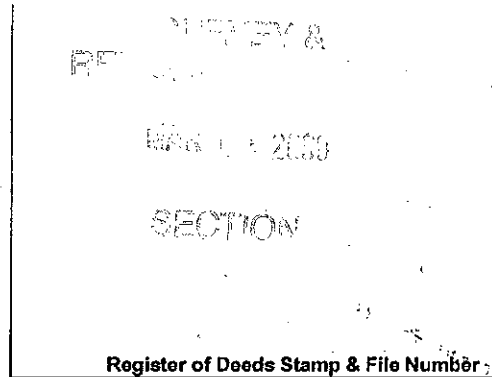

I, Craig W. McVean, in a field survey on Feb. 25 19 98 do hereby state that under requirements of P.A. 74, Michigan P.A. of 1970, the corner points mentioned in lines 1 and 2 above were in conformance with regulations and rules therefore as required in the current manual of survey instructions of the United States Department of the Interior, Bureau of Land Management or by a decree of a Court of Law and /or that the corner points mentioned in lines 3, 4 and 5 above were in conformance with the rules of the Michigan Board of Land Surveyors or by a Decree of a Court of Law; established, re-established, monumented, recovered, found as expressed below:

**NOTE: Not more than 2 corners, all in the same town and range, may be recorded on this certificate.**

1	A	B	C	D	E	F	G	H	I	J	K	L	M
2	6	5	4	3	2	1							
3													
4	7	8	9	10	11	12							
5													
6	18	17	16	15	14	13							
7													
8	19	20	21	22	23	24							
9													
10	30	29	28	27	26	25							
11													
12	31	32	33	34	35	36							
13													

**A. Description of original monument and accessories and/or subsequent restoration:**

- K-4 - GLO - Set 1/4" post.- Tho. Whelpley - 1853  
 Beech 6" S70°E 7 L.  
 Sugar 14" N24°W 13 L.
- Fargo Eng. - B.L. Caukin - 1912 - Fnd old stake & Beech BT 12" S74 1/2°E 7 L. Sugar gone, but crackle knoll where it probably stood. Set Iron post and 2 saucer dishes.  
 Sugar stub 16" S23°W 69.5 L.  
 Beech 6" N30°W 63 L.
- LCRC - L.2 P.35- Norman F. Parker - 1978  
 Fnd 3/4" pipe  
 16" Poplar N50°E 27.5'  
 Spike in 4" Maple S23°E 26.5'  
 Fence is 5' E.
- Consumers P.C. - D.A. Ankrom - 1980 - Fnd 3/4" iron  
 6" Maple N2°W 34.88'  
 8" Poplar N50°E 27.78'  
 5" Poplar E 36.48'

**Ratified by Peer Group**  
**P.A. 345 - 1990 Kalkaska Count.**  
**Chairman** Craig W. McVean  
**Date** 9-14-99

**B. Description of corner evidence found and/or method applied in restoring or reestablishing corner:**

K-4 - 1/4 Corner common to Sec. 11 and Sec. 12, T25N, R7W - Fnd. 1 1/2" O.D. x 2.3' long iron pipe with hook foot end per Fargo Eng. & used by Parker & CPC. Also FND. intact butter dish and pieces of another at pipe base. Down N-S fence is 6' ± E. CL of N-S two track is 10' ± W. Fargo Pipe accepted as a careful and faithful perpetuation of the position of the original corner.

**C. Description of monument for corner and accessories established to perpetuate locating the position of the corner:**

K-4 - Replaced 1 1/2" O.D. Iron pipe w/ 4" DNR Alum. cap on 1" x 36" iron pipe. Reset butter dish crockery at base of pipe as memorial.  
 S89°E 36.47' to Set N&T in N. Side 15" Poplar (CPC).  
 N5°W 35.32' to Set N&T in W. Side Tri. 15" Maple Clp. (CPC).  
 S45°E 16.96' to Set N&T in SW. Side 8" Ash - scribed 'XBT'.  
 N26°E 37.68' to Set N&T in E. Side 14" Ash - scribed 'XBT'.  
 N47°E 59.60' to Set N&T in SE Side 6" Maple clp. of 8 - scribed 'XBT'.  
 Set Orange Carsonite post 1' N.



Signed by Craig W. McVean  
 Surveyor's Michigan License No. 39088

Date 12/9/1999