


LAND CORNER RECORDATION CERTIFICATE

Filing Requirement of Act 74, Mich. PA 1970

For Corners In:		
<u>KALKASKA</u>	Located In	Corner Code #
(County)		
1. Public Land Survey	T <u>25N</u> R <u>7W</u>	<u>L-1</u>
	T <u>26N</u> R <u>7W</u>	<u>L-13</u>
2. Property Controlling in Section	S _____ T _____ R _____	_____
	S _____ T _____ R _____	_____
3. Miscellaneous Property in Section	S _____ T _____ R _____	_____
	S _____ T _____ R _____	_____
4. Lot No: _____	Recorded Plat: _____	
5. Private Claims: _____		

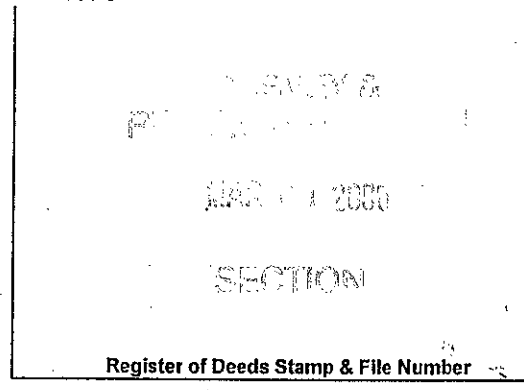

	A	B	C	D	E	F	G	H	I	J	K	L	M
1													
2	6		5		4		3		2		1		
3													
4	7		8		9		10		11		12		
5													
6	18		17		16		15		14		13		
7													
8	19		20		21		22		23		24		
9													
10	30		29		28		27		26		25		
11													
12	31		32		33		34		35		36		
13													

I, Craig W. McVean, in a field survey on Feb 3, 1999 do hereby state that under requirements of PA 74, Michigan PA of 1970, the corner points mentioned in lines 1 and 2 above were in conformance with regulations and rules therefore as required in the current manual of survey instructions of the United States Department of the Interior, Bureau of Land Management or by a decree of a Court of Law and/or that the corner points mentioned in lines 3, 4 and 5 above were in conformance with the rules of the Michigan Board of Land Surveyors or by a Decree of a Court of Law; established, re-established, monumented, recovered, found as expressed below:

NOTE: Not more than 2 corners, all in the same town and range, may be recorded on this certificate.

A. Description of original monument and accessories and/or subsequent restoration:

L-1 & L-13 – GLO – Resurvey – Set ¼ Sec. Post – W. Burt – 1849
 Maple 6" N40°E 8 L.
 Maple 4" N70W 7 L.
 -Fargo Eng.-1912 – No U.S. evidence – Set Iron Pipe with Crockery – SP
 Elm 6" N12°W 42 L.
 Maple 14" S7°W 69 L.
 -W.S.Merrill – 1928 – L.1, P.55 – Co. Surv. Bk. – Iron Pipe
 -Richards Finderoff Richard – 1968- FND. Iron pipe

Rec. Survey – L.3, P.102- 1987 – Farrier Surveying – Fnd. 1" Iron Pipe by Fargo 1912
 S15°W 20.90' – F. Post
 S87°E 21.13' – F. Post
 N86°W 33.77' – F. Post

Ratified by Peer Group
P.A. 345 - 1990 Kalkaska County
 Chairman [Signature]
 Date 12-14-99

B. Description of corner evidence found and/or method applies in restoring or re-establishing corner:

L-1 & L-13 – ¼ Corner common to Section 1, T25N, R7W & Section 36, T26N, R7W. Found loose 1" iron Pipe per Fargo Eng. with ' Y ' Iron Guard in Swamp.
 Removed 1" x 2.3' long Iron Pipe with hook end per Fargo. Dug down and looked for Crockery, none found.
 Found Post bottom is on SE side of Pipe- fence remains E,W&S. Fargo pipe accepted as the best available evidence of the position of the original corner.

C. Description of monument for corner and accessories established to perpetuate locating the position of the corner:

L-1 & L-13 – Replaced 1" X2.3' Iron pipe w/ 4" DNR Alum. Cap on 1" x 8' long Galv. Iron Pipe-up 1' Fnd. ' Y ' Iron top is 0.66' South
 East 20.95' to Fnd. nail in S. side wood fence post (EF)
 N01°W 13.79' to set ½" x 24" Rebar
 West 33.84' to Fnd. nail in S. side wood fence post (EF)
 S38°E 25.47' to set 4' Range Pole bottom
 Set Blue Carsonite Post 1' SE



Signed by: Craig W. McVean
 Surveyor's Michigan License No.: 39088

Date: 12/9/1999