

LAND CORNER RECORDATION CERTIFICATE
Filing Requirement of Act 74, Mich. P.A. 1970

For corners in

Kalkaska Located In: Corner Code #
 (County)

1. Public Land Survey T 25N R 6W A-5
 T 25N R 7W M-5

2. Property Controlling S T R
 in Section S T R

3. Miscellaneous S T R
 Property in Sec. S T R

REGISTERED
 SURVEY &
 MAR 11 2000
 SECTION
 Register of Deeds Stamp & File Number

4. Lot No. _____, Recorded Plat _____
 5. Private Claims _____

I, Craig W. McVean, in a field survey on Feb. 19 19 98 do hereby state that under requirements of P.A. 74, Michigan P.A. of 1970, the corner points mentioned in lines 1 and 2 above were in conformance with regulations and rules therefore as required in the current manual of survey instructions of the United States Department of the Interior, Bureau of Land Management or by a decree of a Court of Law and for that the corner points mentioned in lines 3, 4 and 5 above were in conformance with the rules of the Michigan Board of Land Surveyors or by a Decree of a Court of Law; established, re-established, monumented, recovered, found as expressed below:

1	A	B	C	D	E	F	G	H	I	J	K	L	M
2	6	5											
3													
4	7	8	9	10	11	12							
5													
6	18	17	16	15	14	13							
7													
8	19	20	21	22	23	24							
9													
10	30	29	28	27	26	25							
11													
12	31	32	33	34	35	36							
13													

NOTE: Not more than 2 corners, all in the same town and range, may be recorded on this certificate.

A. Description of original monument and accessories and/or subsequent restoration:

- A-5&M5 - GLO - Set Post - 1839 - H. Bervoot Jr. & J. Mullett
 Cedar 18" N37°W 4 L.
 Cedar 12" S22°W 11 L.
- GLO - G.H. Cannon- 1852-T25N,R6W
 Cedar 14" S36°E 26 L.
 Cedar 12" N45°E 21 L.
- Fargo Eng.- BK 342, P. 12 & 17 - 1912
 Fnd. Old Stake & Both US Wit.
 Set Iron & Crockery Mon.
- M. Schaaf - 1940 - Fnd. all 4 BT stp. with CPC Iron & Old Cedar Stake at corner.
- Unrec. Sur.- Delamater - Muschell #57-56 - Sec. 12-1957
- C.F. Roser - L. 2, P. 228 - Fnd 1" Pipe Add DNR Mon. & Cedar Post-1981
 9" Cedar N10°E 18.9'
 9" Spruce N80°W 27.5'
 10" Tam S25°W 23.9'
- Unrecorded Sur. By N. Parker - Sec. 12
 Fnd. 3/4" Pipe & Post
 NBT 9" Cedar N9°E 19.0'
 NBT 10" Spruce N86°W 27.3'


B. Description of corner evidence found and/or method applied in restoring or reestablishing corner:

A-5 & M5 - Corner common to Sec. 7 & 18, T25N, R6W and Sec. 12 & 13, T25N, R7W. - Fnd. 1 1/2" O.D. x 2.3' long iron pipe with hook end per Fargo Eng. with DOC Pipe Mon. on SW side in swamp. Removed pipes and fnd. 3 stake bottoms and 4 pieces of broken Crockery. Also Fnd. NW & SW GLO Cedar stp. BT's in place. Accepted Fargo pipe as true corner. Reset 4" DOC (DNR) Brass Cap on 1" x 3.5' iron pipe at Fargo pipe position & placed crockery around base & wood stakes along side. DOC (DNR) Monument accepted as a careful & faithful perpetuation of the position of the original corner.

C. Description of monument for corner and accessories established to perpetuate locating the position of the corner:

- A-5 & M5 - 4" Dept. of Conservation Brass Cap on 1" x 3.5' Galv. iron Pipe.
 N5°E 19.29' to set N&T in E. side 12" Cedar (NP, CFR)
 N90°W 27.78' to set N&T in N. side 10" spruce (NP, CFR)
 S18°W 24.18' to set N&T in NW side 10" Tamarack (CFR)
 S38°W 61.05' to set N&T in SE side 11" Cedar scribed 'XBT'
 N66°W 76.08' to set N&T in SW side 12" Cedar scribed 'XBT'
 SW 1.3' to face fd. 6" Cedar Post & SE 0.4' to face fd. 4" Cedar Post
 Set Blue Carsonite Post 1' W.

Ratified by Peer Group
 P.A. 345 - 1990 Kalkaska County
 Chairman [Signature]
 Date 9-14-99

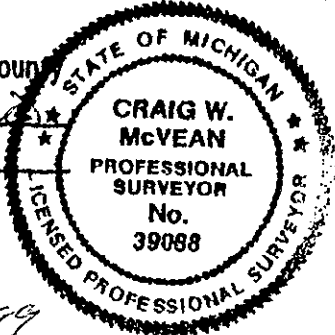

Signed by Craig W. McVean
 Surveyor's Michigan License No. 39088

Date 12/9/1999