

STATE OF MICHIGAN
DEPARTMENT
OF
NATURAL RESOURCES


LAND CORNER RECORD

KALKASKA COUNTY
T 25 N R 7 W

DESCRIPTION OF CORNER N 1/8 corner on N-S 1/4 line Sec. 32.
CORNER MONUMENT Set 1"x36" pipe w/ cedar post & loc. tag.
DATE MONUMENT PLACED AND WITNESSED 1-12-72

WITNESSES TO CORNER.....

<u>3" Cherry</u>	<u>N 88 W</u>	<u>55.5'</u>
<u>4" Cherry</u>	<u>S 44 W</u>	<u>24.3'</u>
<u>4" Cherry</u>	<u>S 24 E</u>	<u>39.2'</u>

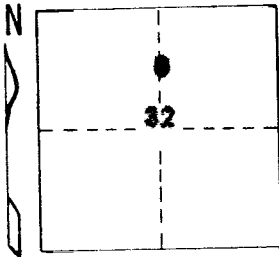


AND

CIRCLE CORNER REGISTERED

DESCRIPTION IN DETAIL AS TO HOW CORNER WAS LOCATED AND IDENTIFIED OR RESTORED.

Established corner per Standard BLM instructions.

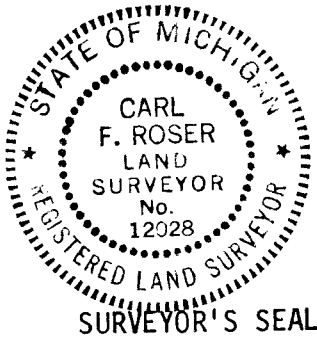

Carl F. Roser

SIGNED

DATE

1-19-72

REGISTERED LAND SURVEYOR 12028

DISTRIBUTION:

County Courthouse
Area Forester (Regions I & II)
District or Region Surveyor
Forestry Div., Lansing