

LAND CORNER RECORDATION CERTIFICATE

Filing Requirement of Act 74, Mich. PA 1970

For Corners In: <u>KALKASKA</u> (County)	Located In	Corner Code #
1. Public Land Survey	T <u>25N</u> R <u>7W</u>	<u>D-11</u>
	T _____ R _____	_____
2. Property Controlling in Section	S _____ T _____ R _____	_____
	S _____ T _____ R _____	_____
3. Miscellaneous Property in Section	S _____ T _____ R _____	_____
	S _____ T _____ R _____	_____


Register of Deeds Stamp & File Number

4. Lot No: _____ Recorded Plat: _____

5. Private Claims: _____

I, Craig W. McVean, in a field survey on June 28, 2000 do hereby state that under requirements of PA 74, Michigan PA of 1970, the corner points mentioned in lines 1 and 2 above were in conformance with regulations and rules therefore as required in the current manual of survey instructions of the United States Department of the Interior, Bureau of Land Management or by a decree of a Court of Law and/or that the corner points mentioned in lines 3, 4 and 5 above were in conformance with the rules of the Michigan Board of Land Surveyors or by a Decree of a Court of Law; established, re-established, monumented, recovered, found as expressed below:

NOTE: Not more than 2 corners, all in the same town and range, may be recorded on this certificate.

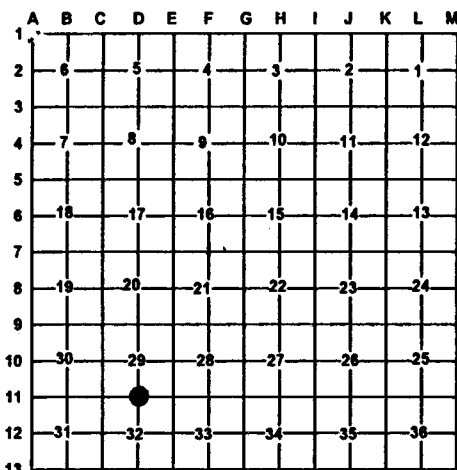

A. Description of original monument and accessories and/or subsequent restoration:


- | | |
|---|---|
| <p><u>D-11</u> - GLO - T. Whelpley - Set QTR Sec. Post - 1853
 S20½° E 8L. 5" Beech, N32°E 31L, 6" Beech
 - Fargo Eng, found & accepted old stake - 1912
 N76½°E 94¾L 40" W.Pine, S70°E 1.76¼L. 36" W. Pine
 - DNR Cor. Rec. - Roser - recovered Fargo ¾" pipe - 1972
 added DNR mon. with cedar post.
 N57°E 79.7' to 4" R. Pine, S81°E 94.8' to 8" R. Pine
 S41°W 30.2' to 5" R. Pine</p> | <p>- Consumers Power Co. - Set Rebar from Record Wit.
 Iron had been pulled - 1981
 6" R. Pine S41°W 30.39', 10" R. Pine S81°E 94.78'
 5" R. Pine N57°E 79.83', N10°W 43.60' to 6" Tri. Maple
 - Rec Sur. L.3, Pg. 291 J.L. Wilcox - 1989 - DNR Mon. w/ post.
 DNR wits listed.</p> |
|---|---|

B. Description of corner evidence found and/or method applies in restoring or re-establishing corner:

- D-11 - ¼ Cor. Common to Sec. 29 & 32
 Fnd. ½" capped iron rebar CPC DAA #21265 in agreement with Rec. Wit.
 Consumers CIR accepted as the best available evidence of the position original corner.

C. Description of monument for corner and accessories established to perpetuate locating the position of the corner:

- D-11 - Replaced CPC ½" rebar with 4" DNR alum. cap on 1"X36" Galv. iron pipe in ring of stones.
 N55°E 79.85' to set N&T in NW side of 10" R. Pine (CFR,CPC)
 S82°E 94.80' to set N&T in N. side of 17" R. Pine (CFR,CPC)
 S38°W 30.41' to set N&T in side of 10" R. Pine (CFR,CPC)
 N6°W 38.66' to set N&T in E. side of 13" S. Maple
 Set Blue Carsonite Post 1' S.

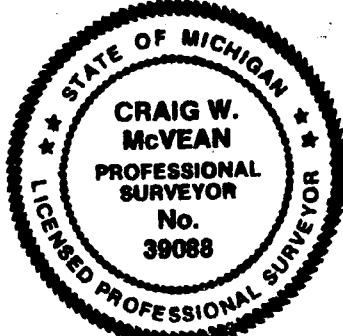

Signed by: Craig W. McVean
 Surveyor's Michigan License No.: 39088

Date: 8/31/2000