

LAND CORNER RECORDATION CERTIFICATE

Filing Requirement of Act 74, Mich. PA 1970

For Corners In: Kalkaska (County)	Located In	Corner Code #
1. Public Land Survey	T _____ R _____ T _____ R _____	_____
2. Property Controlling in Section	S 32 T 25N R 7W S 32 T 25N R 7W	2 7
3. Miscellaneous Property in Section	S _____ T _____ R _____ S _____ T _____ R _____	_____


4. Lot No: _____ Recorded Plat: _____

5. Private Claims: _____

I, Craig W. McVean, in a field survey on June 28, 2000 do hereby state that under requirements of PA 74, Michigan PA of 1970, the corner points mentioned in lines 1 and 2 above were in conformance with regulations and rules therefore as required in the current manual of survey instructions of the United States Department of the Interior, Bureau of Land Management or by a decree of a Court of Law and/or that the corner points mentioned in lines 3, 4 and 5 above were in conformance with the rules of the Michigan Board of Land Surveyors or by a Decree of a Court of Law; established, re-established, monumented, recovered, found as expressed below:

NOTE: Not more than 2 corners, all in the same town and range, may be recorded on this certificate.

Register of Deeds Stamp & File Number

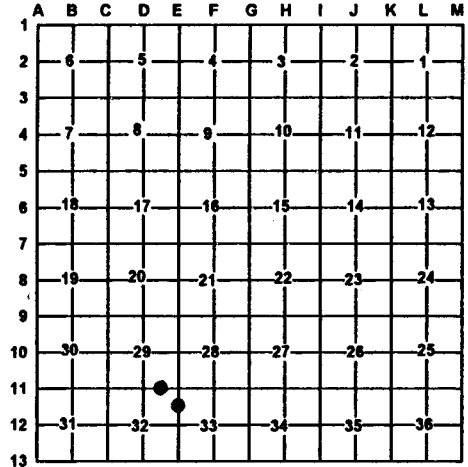

A. Description of original monument and accessories and/or subsequent restoration:

- | | |
|--|---|
| <p><u>2</u> - DNR Cor. Rec.- C. Roser - set 1" X 36" pipe with cedar Post and location tag - 1972.
S87°W 10.8' Maple clump of 3,
N22°W 59.4' 5" Cherry clump of 5
N49°E 95.3' Maple clump of 3</p> | <p><u>7</u> - Rec. Sur. L.2 Pg. 305 - F.H. Thomson - 1978 Set 1/2" iron rod
- Rec. Sur. L.3 Pg. 29 - D.E. Schripsema - 1989
1/2" iron w/cap</p> |
|--|---|

B. Description of corner evidence found and/or method applies in restoring or re-establishing corner:

- | | |
|---|--|
| <p><u>2</u> - E 1/16 Cor. common to Sec. 32 & 29
Found 1" pipe 1' North & East of cedar post with location tag per Roser.</p> | <p><u>7</u> - N 1/16 Cor. common to Sec. 32 & 33.
Fnd. 1/2" capped iron rod JLW #14102
C/L of N-S bit Rd is 87' East</p> |
|---|--|

C. Description of monument for corner and accessories established to perpetuate locating the position of the corner:

- | | |
|---|---|
| <p><u>2</u> - 1" Iron Pipe
Set blue carsonite post with location tag 1' SW
S87°W 10.75' to set N&T in S. side of
12" R. Maple clp. of 3 (CFR)
N49°E 95.87' to set N&T in S. side of
13" R. Maple clp. of 2 (CFR)
N86°E 9.12' to set N&T in N side of 9" W. Pine
S28°E 19.95' to set N&T in W side of 6" R. Pine</p> | <p><u>7</u> - 1/2" capped Iron rod # 14102
N74°E 49.06' to set N&T in S. side of 14" R. Pine
S8°E 37.07' to set N&T in W. side of 18" W. Pine
N79°W 20.49' to Chiseled 'X' in SE corner of garage
Foundation.
N4°E 94.74' to set N&T in E side of 32" W. Pine</p> |
|---|---|

Signed by: Craig W. McVean
Surveyor's Michigan License No.: 39088

Date: 8/31/2000

