

# LAND CORNER RECORDATION CERTIFICATE

Filing Requirement of Act 74, Mich. PA 1970

For Corners In:

Kalkaska  
(County)

Located In

Corner Code #

- |                                      |   |   |     |  |   |    |  |    |
|--------------------------------------|---|---|-----|--|---|----|--|----|
| 1. Public Land Survey                |   | T | 25N |  | R | 6W |  | A8 |
|                                      |   | T | 25N |  | R | 7W |  | M8 |
| 2. Property Controlling in Section   | S | T |     |  | R |    |  |    |
|                                      | S | T |     |  | R |    |  |    |
| 3. Miscellaneous Property in Section | S | T |     |  | R |    |  |    |
|                                      | S | T |     |  | R |    |  |    |

4. Lot No: \_\_\_\_\_ Recorded Plat: \_\_\_\_\_

5. Private Claims: \_\_\_\_\_

I, Craig W. McVean, in a field survey on March 3, 2004 do hereby state that under requirements of PA 74, Michigan PA of 1970, the corner points mentioned in lines 1 and 2 above were in conformance with regulations and rules therefore as required in the current manual of survey instructions of the United States Department of the Interior, Bureau of Land Management or by a decree of a Court of Law and/or that the corner points mentioned in lines 3, 4 and 5 above were in conformance with the rules of the Michigan Board of Land Surveyors or by a Decree of a Court of Law; established, re-established, monumented, recovered, found as expressed below:

**NOTE: Not more than 2 corners, all in the same town and range, may be recorded on this certificate.**

Register of Deeds Stamp & File Number

A	B	C	D	E	F	G	H	I	J	K	L	M
1												
2	6		5		4		3		2		1	
3												
4	7		8		9		10		11		12	
5												
6	18		17		16		15		14		13	
7												
8	19		20		21		22		23		24	
9												
10	30		29		28		27		26		25	
11												
12	31		32		33		34		35		36	
13												

A. Description of original monument and accessories and/or subsequent restoration:


- A8 & M8 – GLO – Set ¼ post – J. Mullett & H. Brevoort – 1839  
 Pine 10" S 15½° W 52 L.  
 Pine 16" N 66° W 91 L.  
 - Fargo Eng. – 1912 – Fd. both U.S. Wit. & Old Stake. Set iron and crockery - W. Pine 8" S74° 30' W 1.12  
 - M. Schaaf – 1940 – Fd. both BT stps. in place and exact

B. Description of corner evidence found and/or method applied in restoring or re-establishing corner:

- A8 & M8 – Standard ¼ Cor. Common to Sec. 19 T25N, R6W and Sec. 24, T25N, R7W – Fd. bent ¾" I.D. x 2.5' long iron pipe w/ hooked end per Fargo Eng. Straighten for point. Excavated pipe and found a couple small pieces of crockery. Fargo pipe in J. Pine clear cut plantation. ¾" Fargo pipe accepted as a careful and faithful perpetuation of the position of the original corner.

C. Description of monument for corner and accessories established to perpetuate locating the position of the corner:

- A8 & M8 – Replaced ¾" Fargo pipe w/ 4" DNR Alum. Cap on 1" x 36" Galv. iron pipe. Place golf ball and a few pieces of crockery around mon. as memorial. Set blue carsonite post 1' N.  
 S 40° E 49.95' to set 5/8" x 1.6' long iron rebar  
 N 10° W 58.45' to set N & T in E. side 7" J. Pine scribed 'XBT'  
 N 40° W 56.37' to set N & T in SW side 5" J. Pine scribed 'XBT'  
 S 54° W 58.31' to set N & T in NW side 5" J. Pine scribed 'XBT'

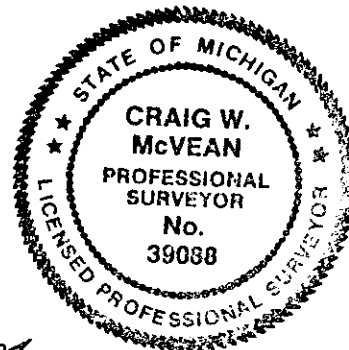

Signed by:

Craig W. McVean

Date:

8/3/2004

Surveyor's Michigan License No.:

39088