

LAND CORNER RECORDATION CERTIFICATE
Filing Requirement of Act 74, Mich. P.A. 1970

For corners in

<u>Kalkaska</u> <small>(County)</small>	Located In:	Corner Code #
1. Public Land Survey	T <u>27N</u> R <u>8W</u>	<u>C - 3</u>
	T _____ R _____	_____
2. Property Controlling in Section	S _____ T _____ R _____	_____
	S _____ T _____ R _____	_____
3. Miscellaneous Property in Sec.	S _____ T _____ R _____	_____
	S _____ T _____ R _____	_____

Register of Deeds Stamp & File Num

4. Lot No. _____, Recorded Plat _____

5. Private Claims _____

I, Craig W. McVean, in a field survey on June, 2 19 97 do hereby state that under requirements of P.A. 74, Michigan P.A. of 1970, the corner points mentioned in lines 1 and 2 above were in conformance with regulations and rules therefore as required in the current manual of survey instructions of the United States Department of the Interior, Bureau of Land Management or by a decree of a Court of Law and for that the corner points mentioned in lines 3, 4 and 5 above were in conformance with the rules of the Michigan Board of Land Surveyors or by a Decree of a Court of Law; established, re-established, monumented, recovered, found as expressed below:

	A	B	C	D	E	F	G	H	I	J	K	L	M
1													
2		6	5			4		3		2		1	
3			●										
4		7	8			9		10		11		12	
5													
6		18	17			16		15		14		13	
7													
8		19	20			21		22		23		24	
9													
10		30	29			28		27		26		25	
11													
12		31	32			33		34		35		36	
13													

NOTE: Not more than 2 corners, all in the same town and range, may be recorded on this certificate.

A. Description of original monument and accessories and/or subsequent restoration:


- C-3 - GLO - Set Beech Post - Lucius Lyon - 1850
 Beech 8" N47°W 30L
 Beech 9" S23°E 58L
- Land Corner Record - from DNR office - K.J. Ostling RLS # 10068 - 4-25-1967
 Section corner common to Sections 5-6-7-8. " Set corner at proportionate measurement North- South, and in line with old established fence and occupation line South. Found large stone at corner which may have been set to mark the corner in previous survey. Checks acceptably for E-W proportion."
 Set 1" pipe with 4" aluminum cap below surface
 10" H. Maple N32°W 27.6'
 9" H. Maple S64°W 27.4'
 - Consumers Power Co. map - August, 1967
 1" Iron with cap
 12" Maple N32°W 28.2'
 10" Maple S64°W 28.0'
 10" Maple N25°E 26.5'

B. Description of corner evidence found and/or method applied in restoring or reestablishing corner:

- C - 3 - Found 4" DNR A.C. on 1" Iron Pipe per KJO and CPC surveys, buried 0.1'. Fences, down, West are 15' ± North and 32' ± South. Fence, down and in trees, South is in line and fence, down and in trees, North is 12' ± East. Monument accepted as a careful and faithful re-establishment of the position of the original corner.

C. Description of monument for corner and accessories established to perpetuate locating the position of the corner:

- C-3 - Built ring of stones around found monument and set blue carsonite post with location tag 16.5' South.
 15" Sugar Maple S62°W 27.97' to set nail and tag in SE side (healed blazes on tree-KJO&CPC)
 16" Sugar Maple N32°W 28.17' to set nail and tag in NE side (healed blazes on tree-KJO&CPC)
 16" Sugar Maple N26°E 26.25' to set nail and tag in SE side (healed blazes on tree-CPC)
 10" Red Pine S30°E 68.01' to set nail and tag in NE side (tree blazed and scribed "XBT")
 10" Red Pine S40°W 77.30' to set nail and tag in SE side (tree blazed and scribed "XBT")

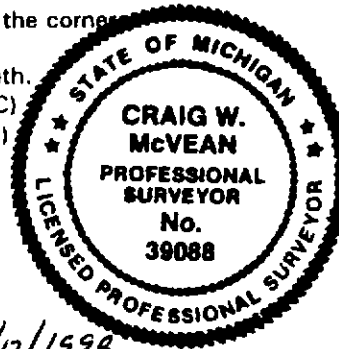

Signed by Craig W. McVean
 Surveyor's Michigan License No. 39088

Date 3/12/1998