

LAND CORNER RECORDATION CERTIFICATE
Filing Requirement of Act 74, Mich. P.A. 1970

For corners in

KALKASKA Located In: Corner Code #
 (County)
 1998 REMONUMENTATION
 1. Public Land Survey T. 25N R. 8W C-2
 T. R.
 T. R.
 T. R.
 2. Property Controlling S. T. R.
 in Section S. T. R.
 3. Miscellaneous S. T. R.
 Property in Sec. S. T. R.

**SURVEY &
 REMONUMENTATION**


FEB 22 1999

SECTION

Register of Deeds Stamp & File Number

4. Lot No. _____, Recorded Plat _____

5. Private Claims _____

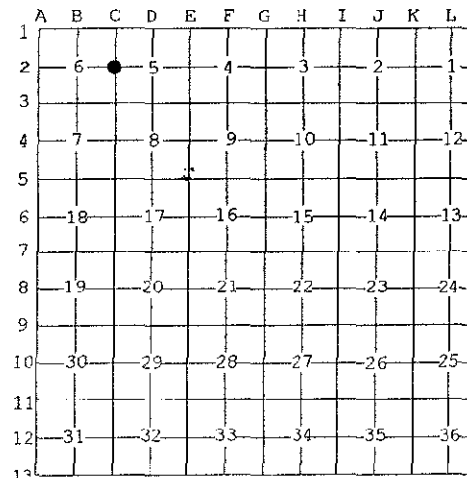

I, EUGENE FARRIER, in a field survey on October 29, 1998 do hereby state that under requirements of P.A. 74, Michigan P.A. of 1970, the corner points mentioned in lines 1 and 2 above were in conformance with regulations and rules therefore as required in the current manual of survey instructions of the United States Department of the Interior, Bureau of Land Management or by a decree of a Court of Law and /or that the corner points mentioned in lines 3, 4 and 5 above were in conformance with the rules of the Michigan Board of Land Surveyors or by a Decree of a Court of Law; established, re-established, monumented, recovered, found as expressed below:

NOTE: Not more than 2 corners, all in the same town and range, may be recorded on this certificate.

A. Description of original monument and accessories and/or subsequent restoration:

C-2: 1/4 Cor. Common to Secs. 5 & 6, T25N-R8W, Springfield Township
 1852, G.L.O. Subd. resurvey by V.W. Cankin D.S.; set corner; Sugar 12", N 33°E, 30 Lks. (19.80'); Hemlock 8", S 15°W, 11 Lks. (7.26')
 1876, Road survey by D.E. McVean Co. Surveyor Co. Survey Bk. Pg. 2; measures to found corner, no accessories
 1905, Sec. sub. survey by W.S. Merrill Co. Surveyor, Co. Surveyor Bk. Pg. 39; found old stake and set iron stake; no accessories
 1907, Sec. sub. survey by W.S. Merrill C.S.; found iron stake; no accessories
 9-17-82, E. Farrier, fd. 3/4" iron pipe, Cert. of Survey

B. Description of corner evidence found and/or method applied in restoring or reestablishing corner:

C-2: 1/4 Cor. Common to Secs. 5 & 6, T25N-R8W, Springfield Township
 Found & accepted 1 1/4" iron pipe, 1' East of centerline of road on occupied line to East as shown in Cert. of Survey by E. Farrier as 3/4" pipe. Added 5/8" X 18" re-bar w/brass cap in mon. box
 No G.L.O. witnesses were found.
 Kalkaska County Peer Group accepted the above monument as the best available evidence of the position of the original corner.

Ratified by Peer Group
 P.A. 345 - 1990 Kalkaska County
 Chairman Eugene Farrier
 Date 2-2-99

C. Description of monument for corner and accessories established to perpetuate locating the position of the corner:

C-2: 1/4 Cor. Common to Secs. 5 & 6, T25N-R8W, Springfield Township
 Found & accepted 1 1/4" iron pipe, 1' East of centerline of road on occupied line to East as shown in Cert. of Survey by E. Farrier as 3/4" pipe. Added 5/8" X 18" re-rod w/ brass cap in mon. box
 S71°W, 108.05' - 8" Jack Pine, set nail & washer
 N83°W, 95.67' - 10" R. pine, set nail & washer
 N56°W, 118.45' - 12" Jack Pine, set nail & washer
 N87°E, 41.52' - Power pole, set nail & washer



Signed by Eugene Farrier
 Michigan License No. 24594

Date 2-8-99 Surveyor's


3012655
 Page: 1 of 1
 02/10/1999 08:31A
 Kalkaska County REMON 9.00 LB: 5 PG: 310

SURVEYORS, JAN. 28, 1977
 REVISED MAY 14, 1979
 REVISED JAN., 1982
 REVISED OCT., 1992