

**LAND CORNER RECORDATION CERTIFICATE**  
**Filing Requirement of Act 74, Mich. P.A. 1970**

For corners in

KALKASKA Located In: Corner Code #  
 (County)  
 1998 REMONUMENTATION  
 1. Public Land Survey T 25N R 8W C-3  
 T     R          
 T     R          
 T     R          
 2. Property Controlling S     T     R      
 in Section S     T     R      
 3. Miscellaneous S     T     R      
 Property in Sec. S     T     R    

**SURVEY &  
 REMONUMENTATION**

**FEB 22 1999**


**SECTION**

Register of Deeds Stamp & File Number

4. Lot No. \_\_\_\_\_, Recorded Plat \_\_\_\_\_

5. Private Claims \_\_\_\_\_

I, EUGENE FARRIER, in a field survey on October 29, 1998 do hereby state that under requirements of P.A. 74, Michigan P.A. of 1970, the corner points mentioned in lines 1 and 2 above were in conformance with regulations and rules therefore as required in the current manual of survey instructions of the United States Department of the Interior, Bureau of Land Management or by a decree of a Court of Law and /or that the corner points mentioned in lines 3, 4 and 5 above were in conformance with the rules of the Michigan Board of Land Surveyors or by a Decree of a Court of Law; established, re-established, monumented, recovered, found as expressed below:

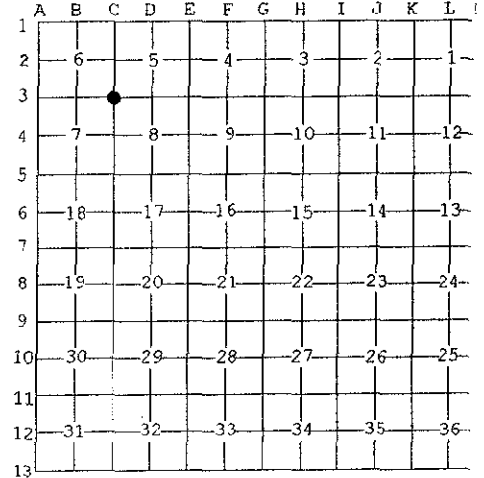

**NOTE:** Not more than 2 corners, all in the same town and range, may be recorded on this certificate.

**A. Description of original monument and accessories and/or subsequent restoration:**

C-3: Sec. Cor. Common to Secs. 5, 6, 7, & 8, T25N-R8W, Springfield Township  
 1852, G.L.O. subd. resurvey by V.W. Cankin D.S.; set post at corner; Sugar 12", N 40°W, 7 Lks. (4.62'); Sugar 20", S 61°E, 34 Lks. (22.44')  
 1876, Road survey by D.E. McVean C.S. Co. Survey Bk. Pg. 2; measures to found corner, no accessories  
 1902, Sec. sub. survey by W.S. Merrill C.S. FB # 15, Pg. 72; found stake; school house fence corner post, S 43°W, 63 Lks. (41.58')  
 1905, 1907, 1920, Sec. sub. survey by W.S. Merrill C.S. FB # 22, Pg. 72, FB # 23, Pg. 45 & FB # 24, Pg. 168; notes stone for corner, school house fence post, S 43°W, 63 Lks. (41.58')  
 1-26-77, F. Thomson, fd 1" square bolt, LCRC in Liber 2, Pg. 6  
 9-17-82, E. Farrier, shows corner only, Cert. of Survey

**B. Description of corner evidence found and/or method applied in restoring or reestablishing corner:**

C-3: Sec. Cor. Common to Secs. 5, 6, 7, & 8, T25N-R8W, Springfield Township  
 Fd. & accepted 1" threaded bolt in centerline of Shippy Road & 4' South of centerline of W. Sharon Road (as recorded in LCRC Liber 2, P 6) Pulled and set 5/8" X 18" re-rod w/brass cap in mon. box.  
 No G.L.O. witnesses were found.  
 Kalkaska County Peer Group accepted the above monument as the best available evidence of the position of the original corner.


**Ratified by Peer Group**  
**P.A. 345 - 1990 Kalkaska County**  
 Chairman Eugene Farrier  
 Date 2-2-99

**C. Description of monument for corner and accessories established to perpetuate locating the position of the corner:**

C-3: Sec. Cor. Common to Secs. 5, 6, 7, & 8, T25N-R8W, Springfield Township  
 Fd. & accepted 1" threaded bolt in centerline of Shippy Road & 4' South of centerline of W. Sharon Road. Pulled and set 5/8" X 18" re-rod w/brass cap in mon. box.  
 N32°E, 62.65' - power pole, found nail  
 S45°E, 47.72', power pole, found nail  
 S22°E, 90.69', power pole, set nail & washer  
 S60°W, 33.1' - Stop sign post (face)

Signed by Eugene Farrier  
 Michigan License No. 24594

Date 2-8-99

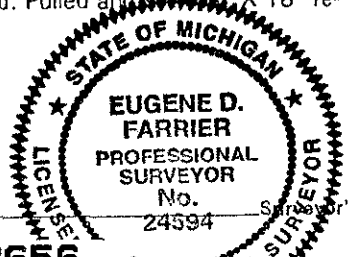

**3012656**  
 Page: 1 of 1  
 02/10/1999 08:31A

REVISIONS: MAY 28, 1998  
 REVISION: MAY 14, 1998  
 REVISION: JAN. 1998  
 REVISION: OCT. 1997