

**LAND CORNER RECORDATION CERTIFICATE**  
**Filing Requirement of Act 74, Mich. P.A. 1970**

SURVEY &  
 RE-MONUMENTATION

MAR 01 2000

For corners in

KALKASKA Located In: Corner Code #  
 (County)  
 1999 REMONUMENTATION  
 1. Public Land Survey T 25N R 8W C-8  
 T      R       
 T      R       
 T      R       
 2. Property Controlling S      T      R       
 in Section S      T      R       
 3. Miscellaneous S      T      R       
 Property in Sec. S      T      R     

SECTION



**3020117**  
 Page: 1 of 1  
 02/04/2000 03:10P  
 REMON  
 LB: 6 PG: 63

Register of Deeds Stamp & File Number

4. Lot No. \_\_\_\_\_, Recorded Plat \_\_\_\_\_  
 5. Private Claims \_\_\_\_\_

	A	B	C	D	E	F	G	H	I	J	K	L	M
1													
2	6		5		4		3		2		1		
3													
4	7		8		9		10		11		12		
5													
6	18		17		16		15		14		13		
7													
8	19		20		21		22		23		24		
9													
10	30		29		28		27		26		25		
11													
12	31		32		33		34		35		36		
13													

I, EUGENE FARRIER, in a field survey on November 8, 1999 do hereby state that under requirements of P.A. 74, Michigan P.A. of 1970, the corner points mentioned in lines 1 and 2 above were in conformance with regulations and rules therefore as required in the current manual of survey instructions of the United States Department of the Interior, Bureau of Land Management or by a decree of a Court of Law and /or that the corner points mentioned in lines 3, 4 and 5 above were in conformance with the rules of the Michigan Board of Land Surveyors or by a Decree of a Court of Law; established, re-established, monumented, recovered, found as expressed below:

**NOTE: Not more than 2 corners, all in the same town and range, may be recorded on this certificate.**

**A. Description of original monument and accessories and/or subsequent restoration:**


C-8: 1/4 Cor. Common to Sec. 19 & 20, T25N-R8W, Springfield Township  
 1852, G.L.O. Resurvey, by V.W. Caukin (Deputy Surveyor) Co. Survey Notes Pg 319, Hemlock 16", S27°E, 9 Lks; Hemlock 8", N47°W, 30 Lks  
 1973, LCRC, by J.L. Wilcox, recorded in Liber 1, Pg 227, set West 1/4 corner of section by splitting 2 West fences and in center of trail to East. Set 1" iron rod, S25°E, 81.55', fence corner; S55°W, 63.26', 2" Jack Pine, N25°W, 119.27', power pole  
 1975;1978, Survey, by J.L. Wilcox, recorded in Liber 1, Pg 888, found 1" iron center of E. Lane of road, same wit as 1973  
 1993, Survey, by E. Farrier (Co. Surveyor), found 1" iron bar, same wits. as Wilcox (1973)  
 1998, Survey, by R. Mitchell, recorded in Reception #3010944, found 1" iron, 6' East, N85°E, 5" Elm, 53.85'; S10°E, 3" J. Pine, 85.97'; S70°W, 4" J. Pine, 68.50'; N25°W, power pole, 119.27'

**B. Description of corner evidence found and/or method applied in restoring or reestablishing corner:**

C-8: 1/4 Cor. Common to Sec. 19 & 20, T25N-R8W, Springfield Township  
 Found 1" solid bar 6' East of centerline N-S road.  
 N85°E, 53.85', 6" Elm, found nail  
 S10°E, 85.97', 3" J. Pine, found nail  
 S70°W, 68.50', 4" J. Pine, found nail  
 N25°W, 119.27', power pole, found nail  
 No G.L.O. witnesses were found.

**Ratified by Peer Group**  
**P.A. 345 - 1990 Kalkaska County**

**Chairman** Eugene Farrier  
**Date** 02-03-00

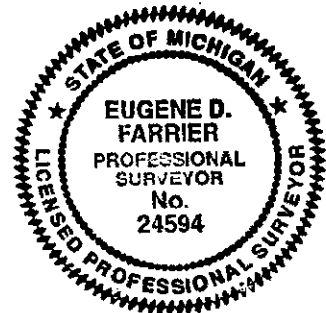

**C. Description of monument for corner and accessories established to perpetuate locating the position of the corner:**

C-8: 1/4 Cor. Common to Sec. 19 & 20, T25N-R8W, Springfield Township  
 Found 1" solid bar 6' East of centerline N-S road. Added 5/8" X 18" rerod w/brass cap & mon. box.  
 N85°E, 53.85', 6" Elm, found nail  
 S10°E, 85.97', 3" J. Pine, found nail  
 S70°W, 68.50', 4" J. Pine, found nail  
 N25°W, 119.27', power pole, found nail  
 Kalkaska County Peer Group accepted the above monument as the best available evidence of the position of the original corner.

Signed by Eugene Farrier  
 Michigan License No. 24594

Date 02-04-00 Surveyor's