

LAND CORNER RECORDATION CERTIFICATE
Filing Requirement of Act 74, Mich. P.A. 1970

For corners in

KALKASKA Located In: _____ Corner Code # _____
 (County)
 1998 REMONUMENTATION
 1. Public Land Survey T 25N R 8W E-3
 T _____ R _____
 T _____ R _____
 T _____ R _____
 2. Property Controlling S _____ T _____ R _____
 in Section S _____ T _____ R _____
 3. Miscellaneous S _____ T _____ R _____
 Property in Sec. S _____ T _____ R _____

**SURVEY &
 REMONUMENTATION**

FEB 22 1999

SECTION

Register of Deeds Stamp & File Number

4. Lot No. _____, Recorded Plat _____
 5. Private Claims _____

1	A	B	C	D	E	F	G	H	I	J	K	L
2		6		5		4		3		2		1
3					●							
4		7		8		9		10		11		12
5												
6		18		17		16		15		14		13
7												
8		19		20		21		22		23		24
9												
10		30		29		28		27		26		25
11												
12		31		32		33		34		35		36
13												

I, EUGENE FARRIER, in a field survey on October 28, 1998 do hereby state that under requirements of P.A. 74, Michigan P.A. of 1970, the corner points mentioned in lines 1 and 2 above were in conformance with regulations and rules therefore as required in the current manual of survey instructions of the United States Department of the Interior, Bureau of Land Management or by a decree of a Court of Law and /or that the corner points mentioned in lines 3, 4 and 5 above were in conformance with the rules of the Michigan Board of Land Surveyors or by a Decree of a Court of Law; established, re-established, monumented, recovered, found as expressed below:

NOTE: Not more than 2 corners, all in the same town and range, may be recorded on this certificate.

A. Description of original monument and accessories and/or subsequent restoration:

E-3: Sec. Cor. Common to Secs. 4, 5, 8 & 9, T25N-R8W, Springfield Township
 1852, GLO. sub resurvey by V.W. Cankin D.S.; Beech 16", S42°W, 51 Lks. (33.66'); Beech 16", N79°E, 38 Lks. (25.08')
 1876, Road survey by McVean CS., Co. Survey Bk. Pg. 2; measured to fd. cor., no/acc.
 1899, Road survey by J.A. Campbell CS. Co. survey Bk. Pg. 3; measured to fd. cor. no/acc.
 1905, Sec. sub survey by W.S. Merrill CS, FB #22, Pg. 72; set stone for cor. by pro. dist.; Pine 40", S12°W, 79 Lks. (52.14'); Pine 40" N12°E, 17 Lks. (11.22')
 10-7-74, C.E. Ostling, found 3/8" bar, Liber 1, Pg. 589, Cert. of Survey
 8-10-84, G. Farrier, shows cor. only, Liber 2, Pg. 841

B. Description of corner evidence found and/or method applied in restoring or reestablishing corner:


E-3: Sec. Cor. Common to Secs. 4, 5, 8 & 9, T25N-R8W, Springfield Township
 Found & accepted 3/8" iron pipe in centerline of road to North, West & East, and 4' West of centerline road to South (as recorded in previous Cert. of Surveys)
 Pulled and set 5/8" X 18" re-bar w/brass cap.
 No G.L.O. witnesses were found.
 Kalkaska County Peer Group accepted the above monument as the best available evidence of the position of the original corner.

Ratified by Peer Group
P.A. 345 - 1990 Kalkaska County

Chairman Eugene Farrier
 Date 2-2-99

C. Description of monument for corner and accessories established to perpetuate locating the position of the corner:

E-3: Sec. Cor. Common to Secs. 4, 5, 8 & 9, T25N-R8W, Springfield Township
 Found & accepted 3/8" iron pipe in centerline of road to North, West & East, and 4' West of centerline road to South (as recorded in previous Cert. of Surveys)
 N74°E, 63.23' - 8" Oak in clump, found nail
 S50°E, 43.60' - Power Pole, found nail
 S16°W, 100.20' - 10" W. Pine, found spike
 S35°W, 100.62' - 8" Jack Pine, set nail & washer

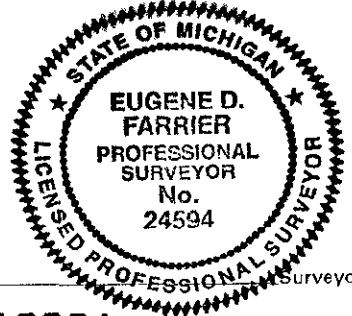

Signed by Eugene Farrier
 Michigan License No. 24594

Date 2-8-99 Surveyor's



3012661
 Page: 1 of 1
 02/10/1999 08:33A
 LB: 5 PG: 316

NAL SURVEYORS, JAN. 28, 1971
 REVISED MAY 14, 1976
 REVISED JAN., 1983
 REVISED OCT., 1991