

LAND CORNER RECORDATION CERTIFICATE
Filing Requirement of Act 74, Mich. P.A. 1970

For corners in

<u>KALKASKA</u>	Located In:	Corner Code #
(County)		
1998 REMONUMENTATION		
1. Public Land Survey	T. <u>25N</u> R. <u>8W</u>	<u>E-5</u>
	T. _____ R. _____	_____
	T. _____ R. _____	_____
	T. _____ R. _____	_____
2. Property Controlling in Section	S. _____ T. _____ R. _____	_____
	S. _____ T. _____ R. _____	_____
3. Miscellaneous Property in Sec.	S. _____ T. _____ R. _____	_____
	S. _____ T. _____ R. _____	_____

SURVEY & REMONUMENTATION

FEB 22 1999

SECTION


Register of Deeds Stamp & File Number

4. Lot No. _____, Recorded Plat _____

5. Private Claims _____

I, EUGENE FARRIER, in a field survey on October 29, 1998, do hereby state that under requirements of P.A. 74, Michigan P.A. of 1970, the corner points mentioned in lines 1 and 2 above were in conformance with regulations and rules therefore as required in the current manual of survey instructions of the United States Department of the Interior, Bureau of Land Management or by a decree of a Court of Law and /or that the corner points mentioned in lines 3, 4 and 5 above were in conformance with the rules of the Michigan Board of Land Surveyors or by a Decree of a Court of Law; established, re-established, monumented, recovered, found as expressed below:

NOTE: Not more than 2 corners, all in the same town and range, may be recorded on this certificate.

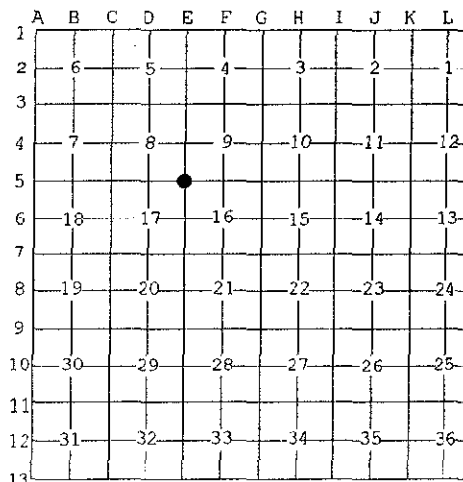

A. Description of original monument and accessories and/or subsequent restoration:

E-5: Sec. Cor. Common to Secs. 8, 9, 16 & 17, T25N-R8W, Springfield Township
 1852, GLO. Sub. resurvey by V.W. Cankin D.S.; set post at corner, Beech 18", N68°W, 26 Lks. (17.16'); Beech 12", S08°E, 15 Lks. (9.90') M.P. on East side Lake, West, 30.5 Ch. (2013.0')
 1907, W.S. Merrill CS, Sec. Sub. Survey, FB #22, Pg. 141; shows stone for corner no/acc.
 10-4-74, C.E. Ostling, found 6" Lag bolt, reset 1/2" iron bar, Liber 1, Pg. 589, Cert. of Survey
 12-16-74, J. Wilcox, found 1/2" pipe in centerline road West & 4' South of centerline road, LCRC, Liber 1, Pg. 338
 5-7-76, J. Fletcher, found R.L.S. Cap #12026, Liber 1, Pg. 856, Cert. of Survey
 5-18-76, J. Fletcher, found R.L.S. Cap #12026, LCRC, Liber 1, Pg. 378
 1-26-77, F. Thomson, found 1/2" pipe, Liber 1, Pg. 958, Cert. of Survey
 9-7-78, H. Fluharty, found 5/8" iron w/cap #12026, 5' South centerline road, LCRC, Liber 2, Pg. 117
 9-18-78, H. Fluharty, found 5/8" iron w/cap #12026, Liber 2, Pg. 227, Cert. of Survey
 10-28-86, R. Mitchell, found 5/8" iron w/cap # 12026, Liber 3, Pg. 71, Cert. of Survey
 2-13-87, R. Mitchell, found 5/8" iron w/cap #12026, Liber 3, Pg. 97-99
 9-7-88, J. Folkens, shows corner only, Liber 3, Pg. 242, Cert. of Survey
 9-7-88, J. Folkens, found re-rod 6.5' South of East-West rd., LCRC, Liber 2, Pg. 354
 11-21-89, E. Farrier, found 5/8" re-rod, Cert. of Survey
 7-15-94, E. Farrier, found 5/8" re-rod, Cert. of Survey
 3-20-95, E. Farrier, found 5/8" re-rod, Cert. of Survey

Ratified by Peer Group
P.A. 345 - 1990 Kalkaska County
 Chairman Eugene Farrier
 Date 2-2-99

B. Description of corner evidence found and/or method applied in restoring or reestablishing corner:


E-5: Sec. Cor. Common to Secs. 8, 9, 16 & 17, T25N-R8W, Springfield Township
 Found and accepted 5/8" iron 5.5' South of centerline of road (as recorded in LCRC's & previous Cert. of Surveys) Added brass cap w/mon box.
 S15°E, 55.43' - 12" R. Pine, found nail
 N37°E, 54.25' - iron & cap #21567
 No G.L.O. witnesses were found.
 Kalkaska County Peer Group accepted the above monument as the best available evidence of the position of the original corner.

C. Description of monument for corner and accessories established to perpetuate locating the position of the corner:

E-5: Sec. Cor. Common to Secs. 8, 9, 16 & 17, T25N-R8W, Springfield Township
 Found and accepted 5/8" iron 5.5' South of centerline of road (as recorded in LCRC's & previous Cert. of Surveys) Added brass cap w/mon box.
 N35°W, 35.07' - 6" Elm, set nail & washer
 N37°E, 54.25' - iron & cap #21567
 S15°E, 55.43' - 12" R. Pine, found nail
 S31°W, 57.43' - 12" R. Pine, found nail

Signed by Eugene Farrier
 Michigan License No. 24594

Date 2-8-99

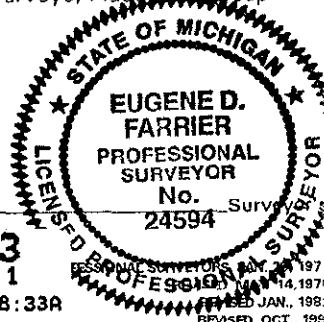

Kalkaska County

REMON

9.00

3012663

Page: 1 of 1

02/10/1999 08:33A

LB: 5 PG: 318

REVISED OCT., 199