

LAND CORNER RECORDATION CERTIFICATE
Filing Requirement of Act 74, Mich. P.A. 1970

MAR 01 2000

For corners in

KALKASKA (County)

Located In: Corner Code #

SECTION

1999 REMONUMENTATION
1. Public Land Survey

T 25N R 8W E-9

2. Property Controlling in Section

S T R

3. Miscellaneous Property in Sec.


S T R

Barcode with text: 3020124 Page: 1 of 1 02/04/2000 03:13P REMON LB: 8 PG: 70 Kalkaska County Joan Hall, Register

Register of Deeds Stamp & File Number

4. Lot No. Recorded Plat

5. Private Claims

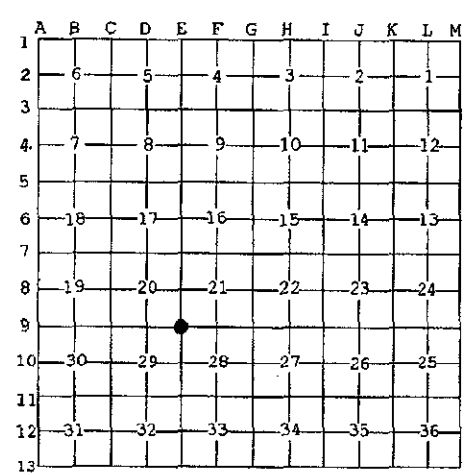

I, EUGENE FARRIER, in a field survey on November 17, 1999 do hereby state that under requirements of P.A. 74, Michigan P.A. of 1970, the corner points mentioned in lines 1 and 2 above were in conformance with regulations and rules therefore as required in the current manual of survey instructions of the United States Department of the Interior, Bureau of Land Management or by a decree of a Court of Law and/or that the corner points mentioned in lines 3, 4 and 5 above were in conformance with the rules of the Michigan Board of Land Surveyors or by a Decree of a Court of Law; established, re-established, monumented, recovered, found as expressed below:

NOTE: Not more than 2 corners, all in the same town and range, may be recorded on this certificate.


A. Description of original monument and accessories and/or subsequent restoration: E-9: Sec. Cor. Common to Sec. 20, 21, 28, & 29, T25N-R8W, Springfield Township

- 1852, G.L.O. Resurvey, by V.W. Caukin (Deputy Surveyor) Co. Survey Notes Pg 312, set post, Beech 8", S45°E, 35 Lks; Beech 8", N85°W, 13 Lks
1904, Survey, by W.S. Merrill (Co. Surveyor) found stone corner, no accessories
1912, Survey, by Fargo, U.S. corner found, W. Pine stump 26", S10°E, 0.57 1/2 Ch.
1972; 1973; 1974, Survey & LCRC, by J.L. Wilcox, (Survey 1972- recorded in Liber 1, Pg 222, Survey 1973- Liber 1, Pg. 331, Survey 1974- Liber 1, Pg. 616; LCRC recorded in Liber 1, Pg. 109) found 1" iron pipe in centerline of E & W road and on centerline of road to South, extended 4" below surface; South, 8" R. Pine, 93.97'; S80°W, power pole, 154.64'; N80°E, telephone pole, 121.43'.
1973, Survey, by J.F. Erickson, recorded in Liber 1, Pg. 422, found same as Wilcox (1972)
1979, Survey, by J.L. Fletcher, recorded in Liber 2, Pg. 475, found 1" iron pipe, set nail in power pole, N25°E, 81.76'; set nail power pole, S70°W, 54.41'; set nail 6" R. Pine, N 58.05'
1984, Survey, by G.D. Smith, recorded in Liber 4, Pg. unknown, same as Fletcher (1979)
1995; 1996; 1998, Survey, by Farrier Surveying, found 1" iron pipe, N05°E, 58.03', 12" R. Pine, N45°W, 72.29', 10" R. Pine; S53°E, 54.35', power pole; S07°W, 94.02', 10" R. Pine
1997, Survey, by N.Livasy, same as Farrier (1995)
1999, Survey, by E. Farrier (Co. Surveyor), same as Kral (1995)

B. Description of corner evidence found and/or method applied in restoring or reestablishing corner: E-9: Sec. Cor. Common to Sec. 20, 21, 28, & 29, T25N-R8W, Springfield Township

Found 1" iron pipe in centerline of E-W road.
N05°E, 58.03', 12" R. Pine, found spike
S53°E, 54.35', power pole, found spike
S07°W, 94.02', 10" R. Pine, found spike
N45°W, 72.29', 10" R. Pine, found spike
No G.L.O. witnesses were found.

Ratified by Peer Group
P.A. 345 - 1990 Kalkaska County
Chairman [Signature]
Date 02-03-06

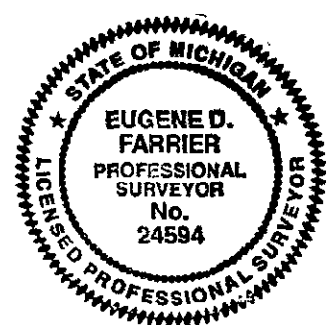

C. Description of monument for corner and accessories established to perpetuate locating the position of the corner: E-9: Sec. Cor. Common to Sec. 20, 21, 28, & 29, T25N-R8W, Springfield Township

Found 1" iron pipe in centerline of E-W road. Added 5/8" X 1 1/2" rerod w/ brass cap in mon. box.
N05°E, 58.03', 12" R. Pine, found spike
S53°E, 54.35', power pole, found spike
S07°W, 94.02', 10" R. Pine, found spike
N45°W, 72.29', 10" R. Pine, found spike
Kalkaska County Peer Group accepted the above monument as a careful and faithful perpetuation of the position of the original corner.

Signed by Eugene Farrier Michigan License No. 24594

Date 02-04-00 Surveyor's