

LAND CORNER RECORDATION CERTIFICATE
Filing Requirement of Act 74, Mich. P.A. 1970

For corners in

<u>KALKASKA</u>	Located In:	Corner Code #
(County)		
1998 REMONUMENTATION		
1. Public Land Survey	T <u>26N</u> R <u>8W</u>	<u>F-13</u>
	T <u>25N</u> R <u>8W</u>	<u>F-1</u> ✓
	T _____ R _____	_____
	T _____ R _____	_____
2. Property Controlling in Section	S _____ T _____ R _____	_____
	S _____ T _____ R _____	_____
3. Miscellaneous Property in Sec.	S _____ T _____ R _____	_____
	S _____ T _____ R _____	_____

SURVEY & REMONUMENTATION
FEB 22 1999
SECTION

Register of Deeds Stamp & File Number

4. Lot No. _____, Recorded Plat _____

5. Private Claims _____

A	B	C	D	E	F	G	H	I	J	K	L
1											
2	6		5		4		3		2		1
3											
4	7		8		9		10		11		12
5											
6	18		17		16		15		14		13
7											
8	19		20		21		22		23		24
9											
10	30		29		28		27		26		25
11											
12	31		32		33		34		35		36
13											

I, EUGENE FARRIER, in a field survey on November 2, 1998 do hereby state that under requirements of P.A. 74, Michigan P.A. of 1970, the corner points mentioned in lines 1 and 2 above were in conformance with regulations and rules therefore as required in the current manual of survey instructions of the United States Department of the Interior, Bureau of Land Management or by a decree of a Court of Law and /or that the corner points mentioned in lines 3, 4 and 5 above were in conformance with the rules of the Michigan Board of Land Surveyors or by a Decree of a Court of Law; established, re-established, monumented, recovered, found as expressed below:

NOTE: Not more than 2 corners, all in the same town and range, may be recorded on this certificate.

A. Description of original monument and accessories and/or subsequent restoration:
F-13: 1/4 Cor. Common to Sec. 33, T26N-R8W, Boardman Township & F-1: 1/4 Cor., Sec. 4, T25N-R8W.

1852, GLO Twp. Line Resurvey by V.W. Cankin, D.S., set corner; Beech 8", N20°W, 24 Lk. (15.84'); Beech 18", N10°E, 28 Lk. (18.48') swamp C. SW-NE West, 9.0 Chs. (594.0')
 1901, Sec. Sub. Survey by W.S. Merrill CS., Co. Survey Bk., Pg. 4 & 29; set iron wagon skein for corner, equal distance between Secti corners.
 6-9-81, N. DeYoung set iron & cap #20705, Cert. of Survey
 11-3-86, R. Mitchell set iron & cap #28417 at post bottom, remains as located by Farrier Survey of 1983, which agrees w/ Merrill Survey of 1901, LCRC Liber 2, Pg. 314


B. Description of corner evidence found and/or method applied in restoring or reestablishing corner:
F-13: 1/4 Cor. Common to Sec. 33, T26N-R8W, Boardman Township & F-1: 1/4 Cor., Sec. 4, T25N-R8W.

Found & accepted iron & cap #28417 4' North of centerline 2-Track, 16.5' South of old fence & 16.5' North of newer East-West fence, and falls on buried North-South fence (As recorded in LCRC Liber 2, Pg. 314) Pulled and set 5/8" X 36" re-bar w/ aluminum cap S20°E, 8.52', fd. rod w/cap #20705
 North, 41.65'- 5" Poplar
 S35°W, 18.65', fence post
 S26°E, 19.28', fence post
 No G.L.O. witnesses were found.
 Kalkaska County Peer Group accepted the above monument as the best available evidence of the position of the original corner.

Ratified by Peer Group
P.A. 345 - 1990 Kalkaska County
 Chairman Eugene Farrier
 Date 2-2-99

C. Description of monument for corner and accessories established to perpetuate locating the position of the corner:
F-13: 1/4 Cor. Common to Sec. 33, T26N-R8W, Boardman Township & F-1: 1/4 Cor., Sec. 4, T25N-R8W.

Found & accepted iron & cap #28417 4' North of centerline 2-Track, 16.5' South of old fence & 16.5' North of newer East-West fence, and falls on buried North-South fence (as recorded in LCRC Liber 2, Pg. 314)
 Pulled & set 5/8" X 36" re-rod w/ brass cap.
 N20°W, 22.21'- 8" Polar, set nail & washer
 N35°E, 55.14'- 6" R. Pine, set nail & washer
 S30°E, 19.58', Wood fence post, set nail & washer
 S31°W, 18.98', Wood fence post, set nail & washer
 S32°E, 8.57', iron & cap #20705

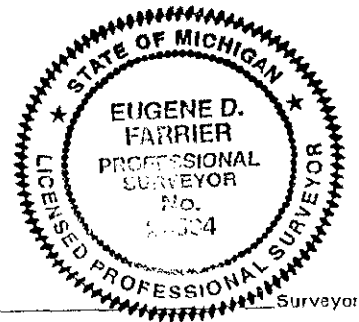

Signed by Eugene Farrier
 Michigan License No. 24594

Date 2-8-99 Surveyor