

LAND CORNER RECORDATION CERTIFICATE  
Filing Requirement of Act 74, Mich. P.A. 1970

SURVEY &  
REMONUMENTATION

For corners in

KALKASKA Located In: Corner Code #  
(County)  
1998 REMONUMENTATION  
1. Public Land Survey T 25N R 8W G-2  
T R  
T R  
T R  
2. Property Controlling S T R  
in Section S T R  
3. Miscellaneous S T R  
Property in Sec. S T R

FEB 22 1999

SECTION

Register of Deeds Stamp & File Number

4. Lot No. \_\_\_\_\_, Recorded Plat \_\_\_\_\_

5. Private Claims \_\_\_\_\_

I, EUGENE FARRIER, in a field survey on November 2, 1998 do hereby state that under requirements of P.A. 74, Michigan P.A. of 1970, the corner points mentioned in lines 1 and 2 above were in conformance with regulations and rules therefore as required in the current manual of survey instructions of the United States Department of the Interior, Bureau of Land Management or by a decree of a Court of Law and for that the corner points mentioned in lines 3, 4 and 5 above were in conformance with the rules of the Michigan Board of Land Surveyors or by a Decree of a Court of Law; established, re-established, monumented, recovered, found as expressed below:

NOTE: Not more than 2 corners, all in the same town and range, may be recorded on this certificate.

1	A	B	C	D	E	F	G	H	I	J	K	L
2		6		5		4	●	3		2		1
3												
4		7		8		9		10		11		12
5												
6		18		17		16		15		14		13
7												
8		19		20		21		22		23		24
9												
10		30		29		28		27		26		25
11												
12		31		32		33		34		35		36
13												

A. Description of original monument and accessories and/or subsequent restoration:

G-2: 1/4 Cor. Common to Secs. 3 & 4, T25N-R8W, Springfield Township  
1852, GLO. Sub. resurvey by V.W. Cankin D.S.; set corner Beech 7", N63°W, 22 Lks. (14.52'); Beech 8", S38°E, 33 Lks. (21.76')  
10-6-94, N. Livasy, set 1/2" iron & cap #31611, by single pro., Cert. of Survey

B. Description of corner evidence found and/or method applied in restoring or reestablishing corner:

G-2: 1/4 Cor. Common to Secs. 3 & 4, T25N-R8W, Springfield Township  
Found and accepted 1/2" iron & cap #31611, 11' West of centerline N-S 2-track.  
Pulled and set 5/8" re-bar w/brass cap.  
No G.L.O. witnesses were found.

Kalkaska County Peer Group accepted the above monument as a careful and faithful reestablishment of the position of the original corner.


Ratified by Peer Group  
P.A. 345 - 1990 Kalkaska County

Chairman Eugene Farrier

Date 2-2-99

C. Description of monument for corner and accessories established to perpetuate locating the position of the corner:

G-2: 1/4 Cor. Common to Secs. 3 & 4, T25N-R8W, Springfield Township  
Found and accepted 1/2" iron & cap #31611, 11' West of centerline N-S 2-track.  
N09°W, 15.56' - 28" Twin Maple, found nail  
S61°E, 23.14' - 16" Poplar, found nail  
S19°W, 37.74' - 22" Maple, found nail  
S45°W, 8.00' - 12" Twin Maple, found nail

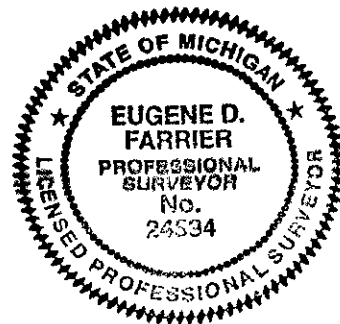

Signed by Eugene Farrier  
Michigan License No. 24534

Date 2-2-99 Surveyor's



3012666

Page: 1 of 1

02/10/1999 08:34A

Kalkaska County REMON 9.00 LB: 5 PG: 321

1971  
1976  
1983  
1991